

FEB 19 1971

MISSISSIPPI
BOARD OF WATER COMMISSIONERS
416 North State Street
Jackson, Mississippi 39201

MISS. BD. OF
WATER COMM.
MISS. BD. OF
WATER COMM.

CODED

WATER WELL DRILLERS LOG

PIKE
H89
1-11-71

Jan 11 1971 date well completed
Chester Keener firm name
Pike county well located

LANDOWNER: Marshall Stallings
KFD - Memphis (mailing address)

description of formations encountered	from	to
shack	0	20
sand	20	60
sand & gravel	60	80
shack	80	95
sand & gravel	95	108

WELL LOCATION:
sec. 21 T 2 N R 8 E
4 miles SE of Memphis (distance) (direction) (nearest town)

WELL PURPOSE: Home (home, irrigation, municipal, industrial)

- WELL COMPLETION DATA:
- (1) diameter (inches) 4"
 - (2) total depth (feet) 108
 - (3) static water level (feet) 75 below top of ground.
 - (4) casing ~~plastic~~ - Ballou (material) (depth)
 - (size) If telescope see back.
 - (5) screen 6" (length) 107 (depth to top)
 - 4" ~~plastic~~ (size) (material)
 - (6) pump ~~per pump power~~ (HP) (yield/gpm)
 - (type power)
 - (7) electric log NO (yes or no)
 - (organization running log)


CODED

(8) how well bottom plugged
wooden plug

DRILLERS REMARKS:

If well telescopes please sketch and show depths.

GROUND LEVEL

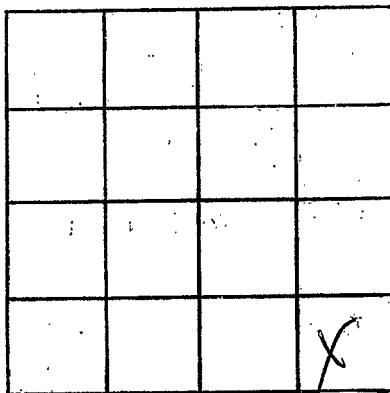

SECTION 21

Please indicate well location X.

ADDITIONAL INFORMATION

If more than one screen, show locations of each on sketch.