

MIKE  
H 91  
9-30-65

MISSISSIPPI BOARD OF WATER COMMISSIONERS

CODED

WATER WELL DRILLERS LOG

CODED

Date: 9-30, 1965, Driller: Chester Reeves County: Pike  
(Name)

(1) Owner of Land: Henry Hunt  
(Name)  
Rt. 1, Mapalia  
(Address)

(2) Location:  $\frac{1}{4}$ ,  $\frac{1}{4}$ , Sec. 23 28 T R  
8 miles East of Mapalia  
(distance) (direction) (Nearest Town)

(3) Topography: Hilly  
(Hilly) (Flat) (Level)

(4) Purpose of Well: Domestic  
(Domestic Irrigation  
Municipal, Industrial, Other)

Description & Color of Materials Sand, Clay, Red Clay, Shell, etc.	Thick- ness Feet	Depth Feet
<u>bed clay</u>	<u>25</u>	<u>25</u>
<u>red sand</u>	<u>25</u>	<u>50</u>
<u>gravel &amp; sand</u>	<u>42</u>	<u>92</u>
<u>granite sand</u>	<u>12</u>	<u>104</u>

Information upon completion of well:

(1) Diameter 4 inches.

(2) Total Depth 104 feet.

(3) Water Level 75 feet below top of ground.

(4) Cased to Bottom Size 4

(5) Screen: Size 4", Length 7'


(6) Were any formations sealed against pollution?  
\_\_\_\_\_ yes,  no.

CODED

If YES depth of formation \_\_\_\_\_

Why \_\_\_\_\_

Drillers Remarks: New Pump

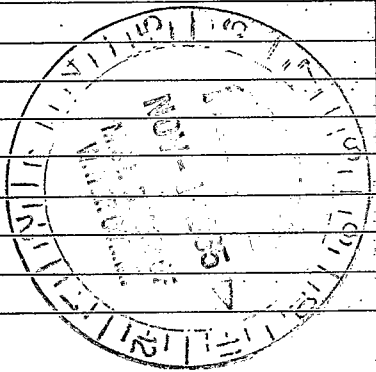

(Use Back Side)

Well No.

[The page contains extremely faint and illegible text, likely bleed-through from the reverse side of the document. The text is scattered across the page and cannot be transcribed accurately.]