

PIKE
H92
2-27-71

MISSISSIPPI
BOARD OF WATER COMMISSIONERS
416 North State Street
Jackson, Mississippi 39201

CODED

WATER WELL DRILLERS LOG

27 Feb 1971 54 Waterwell Pike
date well completed firm name county well located

LANDOWNER:
Virgil Hamilton
Magnolia
(mailing address)

WELL LOCATION:
sec. 9 T2 N R 8 E
(distance) miles (direction) of (nearest town)

WELL PURPOSE:
(home, irrigation, municipal, industrial)

- WELL COMPLETION DATA:
- (1) diameter (inches) 4
 - (2) total depth (feet) 250
 - (3) static water level (feet) 90 below above top of ground.
 - (4) casing PI 150
(material) (depth)
(size) if telescope see back.
 - (5) screen 6 150
(length) (depth to top)
4 PI
(size) (material)
 - (6) pump 3 10
(HP) (yield gpm)
elect
(type power)
 - (7) electric log (yes or no)
 - (organization running log)
 - (8) how well bottom plugged Wood

| description of formations encountered | from | to |
|---------------------------------------|------|-----|
| clg | 0 | 15 |
| chuck | 15 | 20 |
| soft chuk | 25 | 60 |
| hard chuk | 60 | 85 |
| chuk | 85 | 160 |
| soft | 160 | 175 |
| chuk | 175 | 210 |
| soft | 210 | 250 |

CODED


MAY 6 1971

DRILLERS REMARKS:

MISS. BD. OF WATER COMM.

If well telescopes please sketch and show depths.

GROUND LEVEL

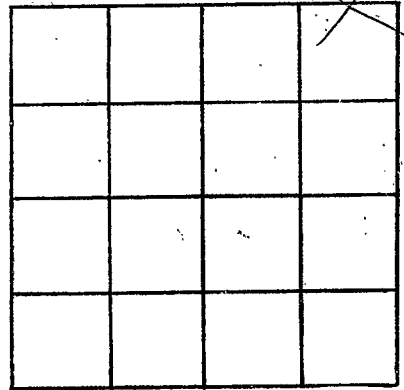

SECTION 9

Please indicate well location X.

ADDITIONAL INFORMATION

If more than one screen,
show locations of each on sketch.