

PIKE
H 93
4-30-71

MISSISSIPPI
BOARD OF WATER COMMISSIONERS
416 North State Street
Jackson, Mississippi 39201

CODED

WATER WELL DRILLERS LOG

April 30 1971 date well completed
Chesters Keenes firm name
Pike county well located

LANDOWNER: Jewell Smith
RT-1, McComb

description of formations encountered	from	to
Red clay	0	18
Red chert	18	47
Red sand	47	100
Small gravel sand	100	170

(mailing address)

WELL LOCATION:
sec. 3 T 2 N R 6 E
4 miles SE of Ferriday
(distance) (direction) (nearest town)

WELL PURPOSE: Sand
(home, irrigation, municipal, industrial)

- WELL COMPLETION DATA:
- (1) diameter (inches) 4"
 - (2) total depth (feet) 170
 - (3) static water level (feet) 101 below top of ground.
 - (4) casing: Cast Bottom
(material) (depth)
 - (size) if telescope see back.
 - (5) screen: 6' (length) 1/4 (depth to top)
1/4" (size) Cast (material)
 - (6) pump: Sub-25 (HP) 25 (yield gpm)
Electric (type power)
 - (7) electric log NO (yes or no)
 - (organization running log)

CODED

(8) how well bottom plugged
wooden plug


MAY 20 1971

DRILLERS REMARKS:
old well had

MISS. RD. OF
WATER COMM.

If well telescopes please sketch and show depths.

GROUND LEVEL

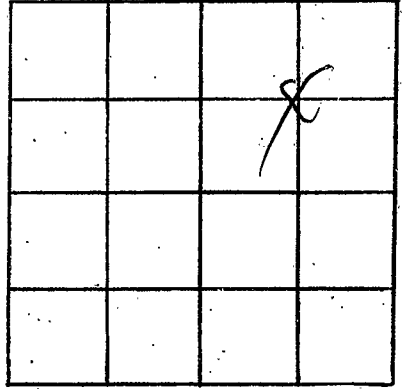

SECTION 3

Please indicate well location X.

ADDITIONAL INFORMATION

If more than one screen,
show locations of each on sketch.