

MISSISSIPPI
BOARD OF WATER COMMISSIONERS
416 North State Street
Jackson, Mississippi 39201

CODED

WATER WELL DRILLERS LOG

PIKE
H94
5-29-71

29 May 1971 date well completed 71 S & R Water Well firm name Pike county well located

LANDOWNER: Virgil Conely
Mapavia
(mailing address)

WELL LOCATION:
sec 21 T 2 N R 8 E
4 miles East of Mapavia
(distance) (direction) (nearest town)

description of formations encountered	from	to
Clay	0	10
Red chert	10	25
Chalk	25	70
Red chert	70	85
Chalk	85	100
Red	100	145

WELL PURPOSE:
(home, irrigation, municipal, industrial)

WELL COMPLETION DATA:

(1) diameter (inches) 4

(2) total depth (feet) 145

(3) static water level (feet) 80 below above top of ground.

(4) casing PI 134
(material) (depth)
(size) if telescope see back.

(5) screen 6 134
(length) (depth to top)
4 PI
(size) (material)

(6) pump 4 8
(HP) (yield gpm)
split
(type power)

(7) electric log (yes or no)

(organization running log)

(8) how well bottom plugged good

CODED


MAY 31 1971

MISS. Bd. OF WATER COMME.

DRILLERS REMARKS:

If well telescopes please sketch and show depths.

GROUND LEVEL

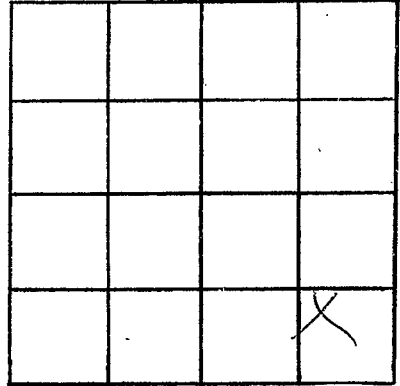

SECTION 21

Please indicate well location X.

ADDITIONAL INFORMATION

If more than one screen,
show locations of each on sketch.