

PIKE
H 95
6-4-71

MISSISSIPPI
BOARD OF WATER COMMISSIONERS
416 North State Street
Jackson, Mississippi 39201

CODED

WATER WELL DRILLERS LOG

4 Jan 1971 588 Water Well P. Kl
date well completed : firm name : county well located :

LANDOWNER:	description of formations encountered	from	to
John Bennis Magnolia (mailing address)	clay red clay sand chalk	0 70 45 70	70 45 70 80
<p>WELL LOCATION:</p> <p>sec. 16 T. 2 N. R. 8 E S W</p> <p>5 miles East of Magnolia (distance) (direction) (nearest town)</p>			
<p>WELL PURPOSE: (home, irrigation, municipal, industrial)</p>			
<p>WELL COMPLETION DATA:</p>			
(1) diameter (inches) 4			
(2) total depth (feet) 130			
(3) static water level (feet) 80 below top of ground.			
(4) casing 81 (material), 124 (depth), if telescope see back.			
(5) screen 6 (length), 124 (depth to top), 4 (size), 81 (material)			
(6) pump 8 (HP), 8 (yield gpm), elect (type power)			
(7) electric log No. (yes or no)			
(organization running log)			
(8) how well bottom plugged wood			
DRILLERS REMARKS:			


CODED

JAN 14 1971

MISS. BD. OF
WATER COMMISSIONERS

If well telescopes please sketch and show depths.

GROUND LEVEL

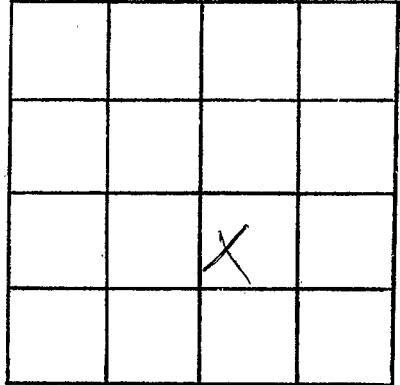

SECTION 16

Please indicate well location X.

ADDITIONAL INFORMATION

If more than one screen,
show locations of each on sketch.