

Pike
H-97
8-12-71

MISSISSIPPI
BOARD OF WATER COMMISSIONERS
416 North State Street
Jackson, Mississippi 39201

CODED

WATER WELL DRILLERS LOG

Aug 17 1971 date well completed
Chester Reeves firm name
Pike county well located

LANDOWNER: Curtis James

RFD - Mapaha

(mailing address)

WELL LOCATION:

sec. 32 T 2 N R. 8 E
4 miles SSE of Mapaha
(distance) (direction) (nearest town)

WELL PURPOSE: Home
(home, irrigation, municipal, industrial)

WELL COMPLETION DATA:

- (1) diameter (inches) 4"
- (2) total depth (feet) 115
- (3) static water level (feet) 78 below top of ground. (above)
- (4) casing Cast Bottom
(material) (depth)
- (size) If telescope see back.
- (5) screen 6' (length) 109 (depth to top)
1/2" (size) Plast (material)
- (6) pump 1/2 sub 12
(HP) (yield gpm)
elect (type power)
- (7) electric log no
(yes or no)

(organization running log)

(8) how well bottom plugged
wood plug

DRILLERS REMARKS:
New Hand

description of formations encountered	from	to
Red clay	0	17
Red & white shale	17	48
Red sand	48	76
gravel	76	84
Red sandy sand	84	100
Small gravel & sand	100	115


CODED

SEP 17 1971

MISS. BD. OF
WATER COMMISSIONERS

If well telescopes please sketch and show depths.

GROUND LEVEL

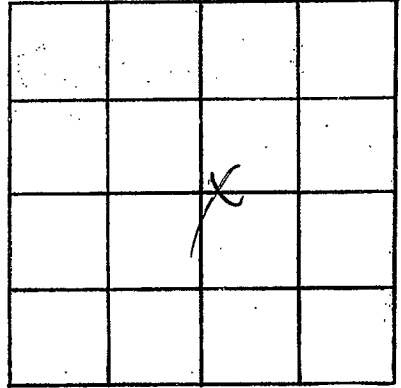

SECTION 32

Please indicate well location X.

ADDITIONAL INFORMATION

If more than one screen,
show locations of each on sketch.