

Pike  
H 98  
10-4-71

MISSISSIPPI  
BOARD OF WATER COMMISSIONERS  
416 North State Street  
Jackson, Mississippi 39201

DEC 6 1971

WATER WELL DRILLERS LOG

**CODED**

10-4-71 date well completed      58 Water Well firm name      8141 county well located

LANDOWNER:  
Abraham Robinson  
Magnolia  
(mailing address)

| description of formations encountered | from      | to         |
|---------------------------------------|-----------|------------|
| <u>Clay</u>                           | <u>0</u>  | <u>20</u>  |
| <u>Chalky Clay</u>                    | <u>20</u> | <u>45</u>  |
| <u>Sand Chalk</u>                     | <u>45</u> | <u>75</u>  |
| <u>Chalky</u>                         | <u>75</u> | <u>95</u>  |
| <u>Good</u>                           | <u>95</u> | <u>127</u> |

WELL LOCATION:  
sec 28 T 2 N R 8 E  
5 miles East of Magnolia  
(distance) (direction) (nearest town)

WELL PURPOSE:  
(home, irrigation, municipal, industrial)

WELL COMPLETION DATA:

(1) diameter (inches) 4"

(2) total depth (feet) 127 ft

(3) static water level (feet) 70 below above top of ground.

(4) casing PI 121  
(material) (depth)  
(size) if telescope see back.

(5) screen 6 121  
(length) (depth to top)  
4 PI  
(size) (material)

(6) pump 1/2 8  
(HP) (yield gpm)  
Elect  
(type power)

(7) electric log (yes or no)

(organization running log)


(8) how well bottom plugged Wood

**CODED**

DRILLERS REMARKS:

If well telescopes please sketch and show depths.

GROUND LEVEL

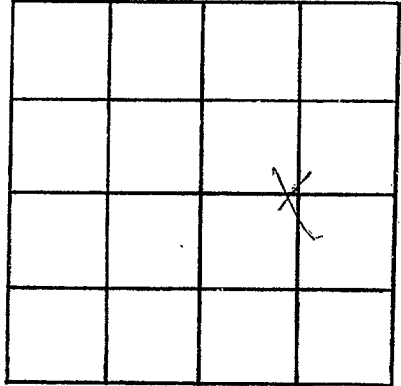

SECTION 28

Please indicate well location X.

ADDITIONAL INFORMATION

Lined area for additional information.

If more than one screen, show locations of each on sketch.