

CODED

MISSISSIPPI
BOARD OF WATER COMMISSIONERS FEB 17 1972

416 North State Street
Jackson, Mississippi 39201

MISS. BO. OF

WATER WELL DRILLERS LOG

PIKE
H101
1-31-72

31 Jan 1972
date well completed

Sprinkler Well
firm name


Pike
county well located

LANDOWNER:	description of formations encountered	from	to
Earl Conroy Mag. (mailing address)			
WELL LOCATION: sec 27 T 2 N R 8 E			
(distance) miles of (direction) (nearest town)			
WELL PURPOSE: (home, irrigation, municipal, industrial)			
WELL COMPLETION DATA:			
(1) diameter (inches) 4			
(2) total depth (feet) 85			
(3) static water level (feet) 40 below top of ground.			
(4) casing (material) PI (depth) 79			
(size) if telescope see back.			
(5) screen (length) 6 (depth to top) 79			
(size) (material) 4 PI			
(6) pump (HP) 1/2 (yield gpm) 8			
(type power) elect.			
(7) electric log (yes or no) (no)			
(organization running log)			
(8) how well bottom plugged Wood			
DRILLERS REMARKS:			

CODED

If well telescopes please sketch and show depths.

GROUND LEVEL

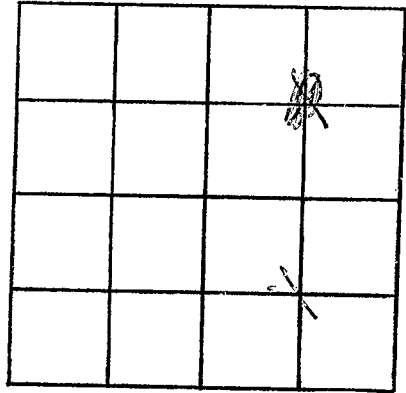

SECTION 22

Please indicate well location X.

ADDITIONAL INFORMATION

Lined area for additional information.

If more than one screen, show locations of each on sketch.