

Pike
 H102
 1-27-72

MISSISSIPPI
 BOARD OF WATER COMMISSIONERS
 416 North State Street
 Jackson, Mississippi 39201

CODED

WATER WELL DRILLERS LOG

Jan 27 1972 date well completed
 Fitzwall Well Serv firm name
 Pepe county well located

LANDOWNER:
 Arthur Stallings
 P.O. Magnolia Miss.
 (mailing address)

description of formations encountered	from	to
Red clay	0	15
Red sand	15	75
Red gravel	75	105
Red sand	65	125
Coarse sand & gravel	125	139

WELL LOCATION:
 sec. 36 T. 20 N. R. 8 E
 9 miles E of Magnolia
 (distance) (direction) (nearest town)

WELL PURPOSE: Home
 (home, irrigation, municipal, industrial)

- WELL COMPLETION DATA:
- (1) diameter (inches) 4
 - (2) total depth (feet) 139
 - (3) static water level (feet) 105 below above top of ground.
 - (4) casing Plastic, 131, (material) (depth)
 4 (size) if telescope see back.
 - (5) screen 8, 131 (length) (depth to top)
 4 (size) Plastic (material)
 - (6) pump 1/2 (HP) 9 (yield gpm)
 elec (type power)
 - (7) electric log 279 (yes or no)
 (organization running log)
 - (8) how well bottom plugged wired


CODED

DRILLERS REMARKS:

FEB 28 1972

If well telescopes please sketch and show depths.

GROUND LEVEL

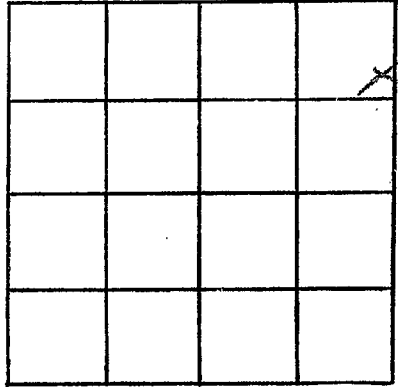

SECTION 36

Please indicate well location X.

ADDITIONAL INFORMATION

If more than one screen,
show locations of each on sketch: