

Pike  
 H 104  
 9-26-72

MISSISSIPPI  
**BOARD OF WATER COMMISSIONERS**  
 10 North State Street  
 Jackson, Mississippi 39201

**WATER WELL DRILLERS LOG**

70 Sept 1972 date well completed  
 J.T. Gorington, P.K.P. firm name  
 county well located


LANDOWNER:	description of formations encountered	from	to
Thomas Wesley Mag. (mailing address)	Clay shale red 2nd run	0 25 55 95	25 55 110
WELL LOCATION: sec. 22 T 2 N R 8 E (distance) miles (direction) of (nearest town)	<b>COPIED</b>		
WELL PURPOSE: (home, irrigation, municipal, industrial)		WELL COMPLETION DATA:	
(1) diameter (inches) 4			
(2) total depth (feet) 110			
(3) static water level (feet) 75 below top of ground.			
(4) casing (material) PL (depth) 104 if telescope see back.			
(5) screen (length) 6 (depth to top) 104 (size) 4 (material) PL			
(6) pump (HP) 1/2 (yield gpm) 5 (type power) electric			
(7) electric log (yes or no)			
(organization running log)			
(8) how well bottom plugged Wind			
DRILLERS REMARKS:			

NOV 23 1972

MISS. BD. OF  
 WATER COM.

If well telescopes please sketch and show depths.

GROUND LEVEL

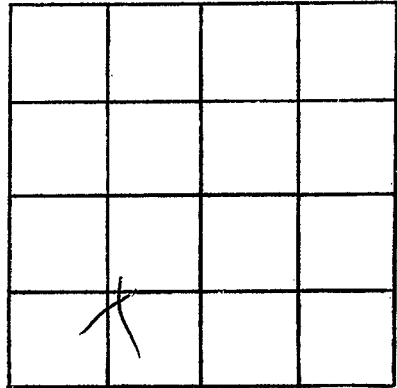

SECTION 22

Please indicate well location X.

ADDITIONAL INFORMATION

If more than one screen,  
show locations of each on sketch.