

MISSISSIPPI
BOARD OF WATER COMMISSIONERS
416 North State Street
Jackson, Mississippi 39201

WATER WELL DRILLERS LOG

Pike
H 106
8-21-72

Aug 21 1972 Chester Keener Pike
date well completed firm name county well located

LANDOWNER Alma
Uranado
At L. Magnolia
(mailing address)

description of formations encountered	from	to
<u>loess sand gravel with clay</u>	<u>0</u>	<u>17</u>
<u>Spud & gravel</u>	<u>17</u>	<u>52</u>
<u>Rock chack</u>	<u>52</u>	<u>56</u>
<u>Coarse sand & peagravel</u>	<u>56</u>	<u>75</u>

WELL LOCATION:
sec. 6 T. 2 N. R. 2 E
2 miles NE Magnolia
(distance) (direction) (nearest town)

WELL PURPOSE: Drain
(home, irrigation, municipal, industrial)

WELL COMPLETION DATA:

- (1) diameter (inches) 4 1/2"
- (2) total depth (feet) 75
- (3) static water level (feet) 45 below top of ground.
- (4) casing Plastic Ballast
(material) (depth)
- (5) screen 6' 6 1/2'
(length) (depth to top)
- (6) pump 4" Sub 15
(HP) (yield gpm)
- (7) electric log NO
(yes or no)

(organization running log)


(8) how well bottom plugged wooden plug

DRILLERS REMARKS:
New house.

DEC 1 1972

If well telescopes please
sketch and show depths.

GROUND LEVEL

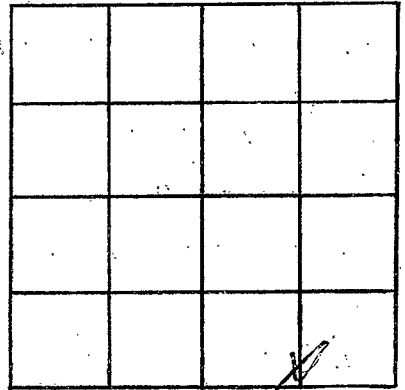

SECTION 6

Please indicate well location X.

ADDITIONAL INFORMATION

If more than one screen,
show locations of each on sketch.