

MISSISSIPPI
 BOARD OF WATER COMMISSIONERS
 416 North State Street
 Jackson, Mississippi 39201

WATER WELL DRILLERS LOG

Pike
 H107
 7-21-72

July 21 1972 date well completed
 Chester Keener firm name
 Pike county well located

LANDOWNER: Charles
 Laird
 Rt-1 Magnolia
 (mailing address)

WELL LOCATION:
 sec. 10 T. 2 N R. 9 E
 4 1/2 miles (distance) E of Magnolia (direction) (nearest town)

WELL PURPOSE: Home
 (home, irrigation, municipal, industrial)

WELL COMPLETION DATA:
 (1) diameter (inches) 4"
 (2) total depth (feet) 120
 (3) static water level (feet) 80 below top of ground.
 (4) casing Plast bottom (material) (depth)
 (size) if telescope see back.
 (5) screen 6' 114' (length) (depth to top)
 1/4" Plast (size) (material)
 (6) pump 1/2 sub 12 (HP) (yield gpm)
 Reel (type power)
 (7) electric log no (yes or no)
 (organization running log)
 (8) how well bottom plugged wooden plug


| description of formations encountered | from | to |
|---------------------------------------|------|-----|
| red clay | 0 | 12 |
| red chack sand | 12 | 68 |
| sand gravel | 68 | 94 |
| sand gravel mixed with chack | 94 | 110 |
| sand & gravel | 110 | 120 |

DRILLERS REMARKS:
 new house

DEC 1 1972

If well telescopes please sketch and show depths.

GROUND LEVEL

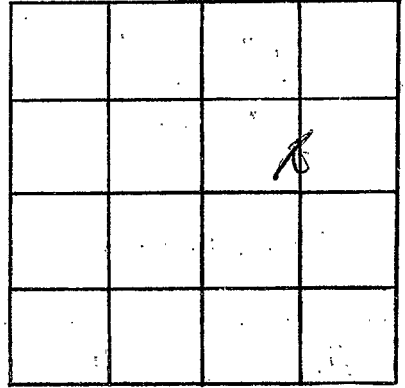

SECTION 10

Please indicate well location X.

ADDITIONAL INFORMATION

If more than one screen,
show locations of each on sketch.