

MISSISSIPPI
BOARD OF WATER COMMISSIONERS
416 North State Street
Jackson, Mississippi 39201

CODED

WATER WELL DRILLERS LOG

Pike
H108
9-1-72

Sept 1 1972 Chester Keene Pike
date well completed firm name county well located

LANDOWNER: Ray Allen
RT-1, Magnolia
F
(mailing address)

WELL LOCATION:
sec. 24 T 2 N R 8 E
6 miles ESE of Magnolia
(distance) (direction) (nearest town)

WELL PURPOSE: drain
(home, irrigation, municipal, industrial)

- WELL COMPLETION DATA:
- (1) diameter (inches) 4"
 - (2) total depth (feet) 113
 - (3) static water level (feet) 68 below
top of ground.
 - (4) casing Plastic Ballam
(material) (depth)
 - (size) if telescope see back.
 - (5) screen 6' 107
(length) (depth to top)
4" Plastic
(size) (material)
 - (6) pump owner's old kit
(HP) (yield gpm)
Elect
(type power)
 - (7) electric log No
(yes or no)

(organization running log)

(8) how well bottom plugged wooden plug

DRILLERS REMARKS:
old tap well
had


description of formations encountered	from	to
<u>Red sandy clay</u>	<u>0</u>	<u>17</u>
<u>Red sand</u>	<u>17</u>	<u>68</u>
<u>Zone of gravel</u>	<u>68</u>	<u>77</u>
<u>Red chalk</u>	<u>77</u>	<u>87</u>
<u>Red chalky sand</u>	<u>87</u>	<u>103</u>
<u>Small gravel band</u>	<u>103</u>	<u>113</u>

CODED

DEC 1 1972

If well telescopes please sketch and show depths.

GROUND LEVEL

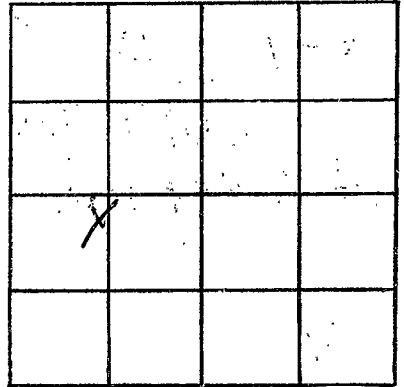

SECTION 24

Please indicate well location X.

ADDITIONAL INFORMATION

If more than one screen,
show locations of each on sketch.