

Pike

H 109

12-13-72

MISSISSIPPI  
 BOARD OF WATER COMMISSIONERS  
 416 North State Street  
 Jackson, Mississippi 39201

WATER WELL DRILLERS LOG

**CODED**

**PIKE**

12-13 1972  
date well completed

Fitzgerald Wells RR, Pike  
firm name county well located

LANDOWNER:

Richmond Connolly  
R.R. 2, McComb, Miss.  
(mailing address)

description of formations encountered

from

to

Red clay	0	20
Red sand & gravel	20	140
Coarse sand & gravel	140	151

WELL LOCATION:

sec. 1 T. 2 N. R. 8 E  
S  
7 miles E of McComb  
(distance) (direction) (nearest town)

WELL PURPOSE:

Home  
(home, irrigation, municipal, industrial)

WELL COMPLETION DATA:


- (1) diameter (inches) 4
- (2) total depth (feet) 151
- (3) static water level (feet) 100 below top of ground.
- (4) casing plastic 143,  
(material) (depth)  
4 if telescope see back.  
(size)
- (5) screen 8, 143  
(length) (depth to top)  
4, plastic  
(size) (material)
- (6) pump 1, 6  
(HP) (yield gpm)  
Clear  
(type power)
- (7) electric log no  
(yes or no)  
(organization running log)
- (8) how well bottom plugged Wood py

**CODED**

DRILLERS REMARKS:

If well telescopes please sketch and show depths.

GROUND LEVEL

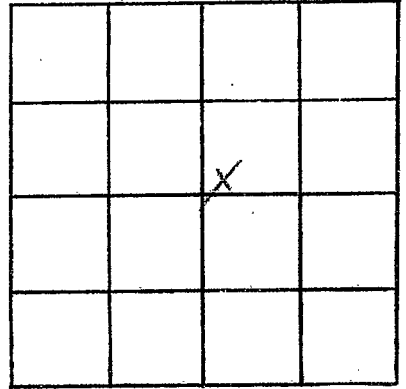

SECTION 1

Please indicate well location X.

ADDITIONAL INFORMATION

If more than one screen, show locations of each on sketch.