

Pike
H 110
1-16-73

MISSISSIPPI
BOARD OF WATER COMMISSIONERS
416 North State Street
Jackson, Mississippi 39201

INDEXED

WATER WELL DRILLERS LOG

1-16 1973 Fitzgerald Well Dr Pike
date well completed firm name county well located

LANDOWNER:
Estell Simons
R.R. Magnolia Min.
(mailing address)

WELL LOCATION:
sec. 14 T. 2 N. R. 8 E.
2 miles E of Magnolia
(distance) (direction) (nearest town)

description of formations encountered	from	to
<u>Red Clay</u>	<u>0</u>	<u>20</u>
<u>Red Sand</u>	<u>20</u>	<u>80</u>
<u>Red gravel</u>	<u>80</u>	<u>100</u>
<u>Red sand</u>	<u>100</u>	<u>128</u>
<u>Coarse Sand Gravel</u>	<u>128</u>	<u>138</u>

WELL PURPOSE: Home
(home, irrigation, municipal, industrial)

- WELL COMPLETION DATA:
- (1) diameter (inches) 4
 - (2) total depth (feet) 138
 - (3) static water level (feet) 80 below top of ground.
 - (4) casing plastic, 130,
(material) (depth)
4 if telescope see back.
(size)
 - (5) screen 8, 130
(length) (depth to top)
4, plastic
(size) (material)
 - (6) pump 1/2 10
(HP) (yield gpm)
Elu
(type power)
 - (7) electric log no
(yes or no)
(organization running log)
 - (8) how well bottom plugged wood plug


INDEXED

JAN 20 1973

DRILLERS REMARKS:

If well telescopes please sketch and show depths.

GROUND LEVEL

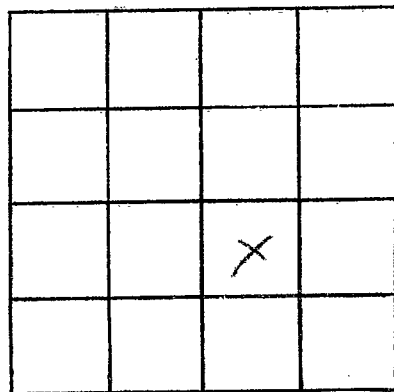

SECTION 14

Please indicate well location X.

ADDITIONAL INFORMATION

If more than one screen,
show locations of each on sketch.