

Pike  
H 112  
1-18-73

MISSISSIPPI  
BOARD OF WATER COMMISSIONERS  
416 North State Street  
Jackson, Mississippi 39201

**CODED**

WATER WELL DRILLERS LOG

Jan 18 1973 Chester Keener Deho  
(date well completed) firm name county well located

LANDOWNER: Rev. Lucian Davis

description of formations encountered from to

Davis  
At Magnolia  
(mailing address)

<u>Red clay</u>	<u>0</u>	<u>16</u>
<u>sand &amp; gravel</u>	<u>16</u>	<u>50</u>
<u>pink chalk</u>	<u>50</u>	<u>73</u>
<u>Mixed chalk &amp; sand</u>	<u>73</u>	<u>118</u>
<u>Sand &amp; rock</u>	<u>118</u>	<u>121</u>
<u>Sand &amp; gravel</u>	<u>121</u>	<u>135</u>

WELL LOCATION:  
sec. 9 T. 2 N. R. 8 E  
2 1/2 miles ENE of Magnolia  
(distance) (direction) (nearest town)

WELL PURPOSE: Home  
(home, irrigation, municipal, industrial)

WELL COMPLETION DATA:

- (1) diameter (inches) 4"
- (2) total depth (feet) 135
- (3) static water level (feet) 58 below top of ground.
- (4) casing Plast Balm  
(material) (depth)
- \_\_\_\_\_ if telescope see back.  
(size)
- (5) screen 6' 179'  
(length) (depth to top)
- 4" Plast  
(size) (material)
- (6) pump 1/2 Sub 12  
(HP) (yield gpm)
- Slect  
(type power)
- (7) electric log no  
(yes or no)

**CODED**

(organization running log)


(8) how well bottom plugged  
wooden plug

DRILLERS REMARKS:  
New house

DATE: 1-18-73

If well telescopes please  
sketch and show depths.

GROUND LEVEL

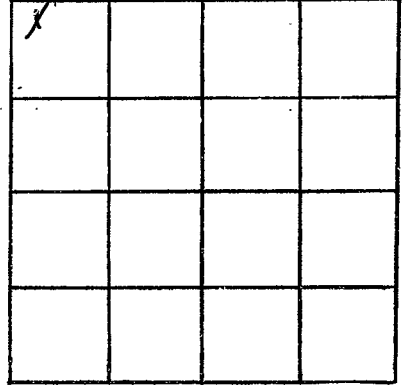

SECTION 9

Please indicate well location X.

ADDITIONAL INFORMATION

If more than one screen,  
show locations of each on sketch.