




If well telescopes please sketch and show depths.

GROUND LEVEL

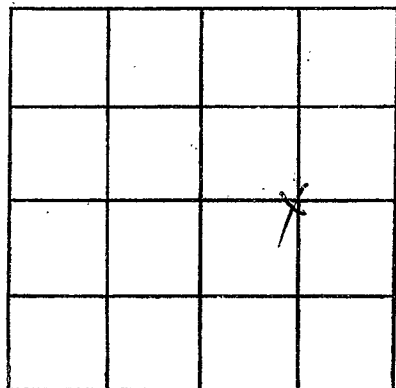

SECTION 34

Please indicate well location X.

ADDITIONAL INFORMATION

If more than one screen,  
show locations of each on sketch.

(MC COMB NORTH)



HOLMESVILLE QUADRANGLE  
MISSISSIPPI  
TOPOGRAPHIC SERIES

(JAYESS)


090° 22' 45.8983" W  
031° 10' 52.9689" N

(PRICEDALE)

090° 20' 27.5972" W  
031° 10' 52.9689" N

(MC COMB SOUTH)

(MESA)

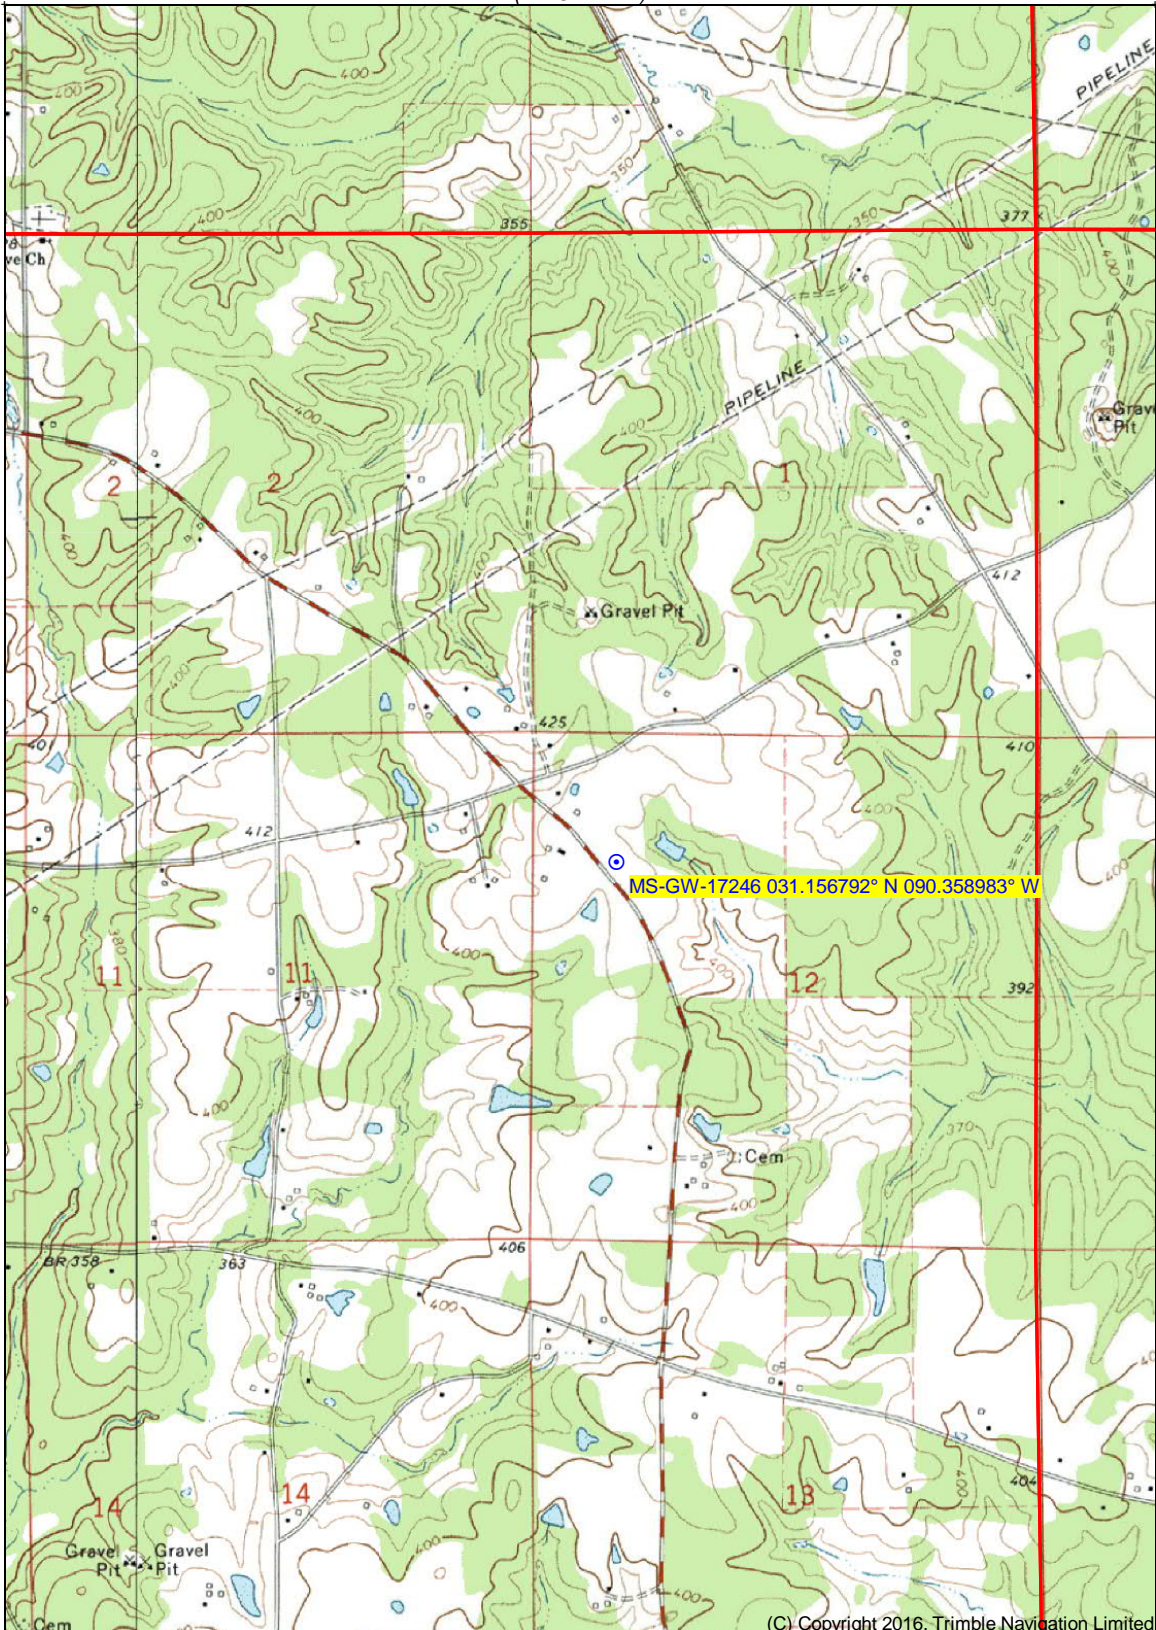

MS-GW-17246 031.156792° N 090.358983° W

(C) Copyright 2016, Trimble Navigation Limited

031° 08' 05.3335" N  
090° 22' 45.8983" W

031° 08' 05.3335" N  
090° 20' 27.5972" W

(PROGRESS)  
SCALE 1:24000

(OSYKA)


(TYLERTOWN)

Produced by Trimble Terrain Navigator Pro  
Topography based on USGS 1:24,000  
Maps

North American 1983 Datum (NAD83)

To place on the predicted North American  
1927 move the projection lines 20M N and  
9M W

Declination

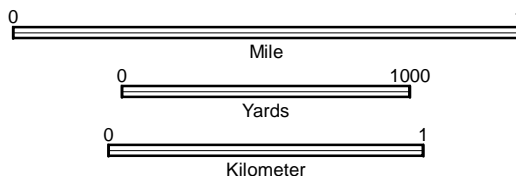

CONTOUR INTERVAL 10 FT

31090-B3-TM-024  
HOLMESVILLE, MS  
JAN 1, 1972