

PIKE
H 114
7-23-73

MISSISSIPPI BOARD OF WATER COMMISSIONERS
416 North State Street
Jackson, Mississippi 39201

CODEL

WATER WELL DRILLERS LOG

24 April 1973 J.T. Bringtonson Pike
date well completed firm name county well located

LANDOWNER:

Mrs. F. Varnado

Mag.

(mailing address)

WELL LOCATION:

sec. 9 T 2 N R 8 E
5 miles E of Mag.
(distance) (direction) (nearest town)

WELL PURPOSE:

(home, irrigation, municipal, industrial)

WELL COMPLETION DATA:

- (1) diameter (inches) 4
- (2) total depth (feet) 125
- (3) static water level (feet) 90 below above top of ground.
- (4) casing PL 119 (material) (depth)
if telescope see back.
- (5) screen 6 119 (length) (depth to top)
4 PL (size) (material)
- (6) pump 1/2 5 (HP) (yield gpm)
elect (type power)
- (7) electric log (yes or no)
- (organization running log)
- (8) how well bottom plugged wood

description of formations encountered

from to

Clay	0	15
Clay Sand	15	35
Sand	35	65
Chalk	65	100
Sand	100	125


CODEL

DRILLERS REMARKS:

JUL 17 1973

If well telescopes please sketch and show depths.

GROUND LEVEL

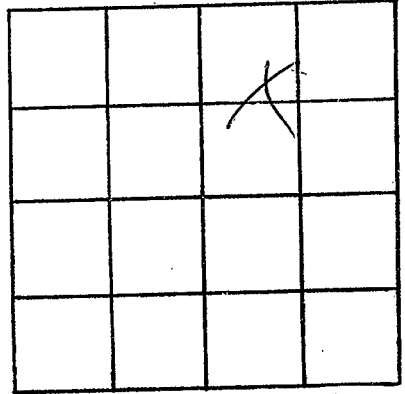

SECTION 9

Please indicate well location X.

ADDITIONAL INFORMATION

If more than one screen,
show locations of each on sketch.