

PIKE
H115
11-16-73

MISSISSIPPI
BOARD OF WATER COMMISSIONERS
416 North State Street
Jackson, Mississippi 39201

WATER WELL DRILLERS LOG **CODED**

16 Nov 1973 Amos Pate Well Serv Pike
date well completed firm name county well located

LANDOWNER:
Koko Phelps
Maple
(mailing address)

description of formations encountered	from	to
<u>Clay</u>	<u>0</u>	<u>20</u>
<u>Clay</u>	<u>20</u>	<u>45</u>
<u>Sand & gravel</u>	<u>45</u>	<u>65</u>
<u>Sand</u>	<u>65</u>	<u>94</u>

WELL LOCATION:
sec. 10 T. 2 N. R. 8 E
6 miles East of Maple
(distance) (direction) (nearest town)

WELL PURPOSE:
(home, irrigation, municipal, industrial)

WELL COMPLETION DATA:

(1) diameter (inches) 4

(2) total depth (feet) 94

(3) static water level (feet) 75 below above top of ground.

(4) casing pl 88
(material) (depth)
if telescope see back.
(size)

(5) screen 6 88
(length) (depth to top)
4 pl
(size) (material)

(6) pump 1/2 8
(HP) (yield gpm)
Electric
(type power)

(7) electric log _____
(yes or no)
(organization running log)

(8) how well bottom plugged good

CODED


DRILLERS REMARKS:

DATE 11-16-73

PIKE

If well telescopes please sketch and show depths.

GROUND LEVEL

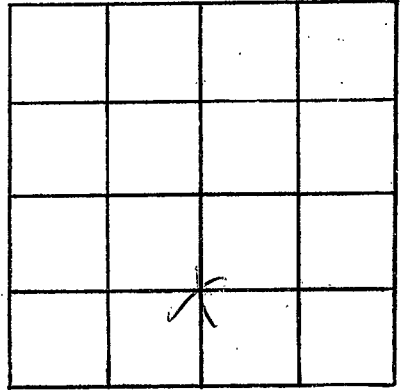

SECTION 10

Please indicate well location X.

ADDITIONAL INFORMATION

If more than one screen,
show locations of each on sketch.