

PIKE
H117
2-11-74

MISSISSIPPI
BOARD OF WATER COMMISSIONERS
416 North State Street
Jackson, Mississippi 39201

CODED

WATER WELL DRILLERS LOG

Feb 11 1974 Chestnut Hill Pike
date well completed firm name county well located

LANDOWNER: Rufus Albert
Rt 1
Oxyba
(mailing address)

WELL LOCATION:
sec 26 T 7 N R 8 E
2 1/2 miles SW of
(distance) (direction) (nearest town)

WELL PURPOSE: Hand
(home, irrigation, municipal, industrial)


WELL COMPLETION DATA:
(1) diameter (inches) 4"
(2) total depth (feet) 116
(3) static water level (feet) 74 below top of ground
(4) casing Plast bottom (material) (depth)
(size) if telescope see back.
(5) screen 6' 110 (length) (depth to top)
4" Plast (size) (material)
(6) pump 1/2 sub 12 (HP) (yield gpm)
2 lead (type power)
(7) electric log No (yes or no)
(organization running log)

(8) how well bottom plugged
wooden plug

DRILLERS REMARKS:
New house


description of formations encountered	from	to
Red clay	0	19
Red clay sand	19	63
Red sand & small gravel	63	87
Red sand, gravel & chalk	87	102
Small gravel & sand	102	116

CODED

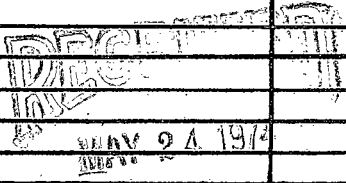

If well telescopes please sketch and show depths.

GROUND LEVEL

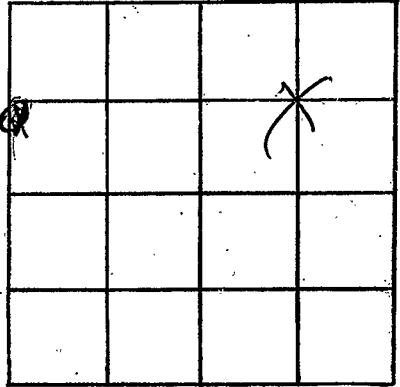

SECTION *27*
30

Please indicate well location X.

ADDITIONAL INFORMATION

If more than one screen,
show locations of each on sketch.