

**MISSISSIPPI  
BOARD OF WATER COMMISSIONERS**  
416 North State Street  
Jackson, Mississippi 39201

**WATER WELL DRILLERS LOGGED**

**PIKE**  
**H118**  
**8/7/74**

7 Aug. 1974  
date well completed

J.T. Gungton  
firm name

Pike  
county well located

**LANDOWNER:**  
Dennis Hamilton  
Magnolia  
(mailing address)

**WELL LOCATION:**  
sec. 10 T 20 N R 8 E  
5 miles of Magnolia  
(distance) (direction) (nearest town)

description of formations encountered	from	to
clay	0	20
Red sand	20	25
sand	25	65
Chalco	65	80
sand	80	136

**WELL PURPOSE:**  
(home, irrigation, municipal, industrial)

**WELL COMPLETION DATA:**

(1) diameter (inches) 4

(2) total depth (feet) 136

(3) static water level (feet) 90 below above top of ground.

(4) casing PI 130  
(material) (depth)  
(size) if telescope see back.

(5) screen 6 130  
(length) (depth to top)  
4 PI  
(size) (material)

(6) pump 1/2 8  
(HP) (yield gpm)  
glut  
(type power)

(7) electric log \_\_\_\_\_  
(yes or no)  
(organization running log)

(8) how well bottom plugged wood

**CODED**


**DRILLERS REMARKS:**

**RECEIVED**  
**OCT 17 1974**

MISS. BD. OF WATER COMMISSIONERS

If well telescopes please sketch and show depths.

GROUND LEVEL

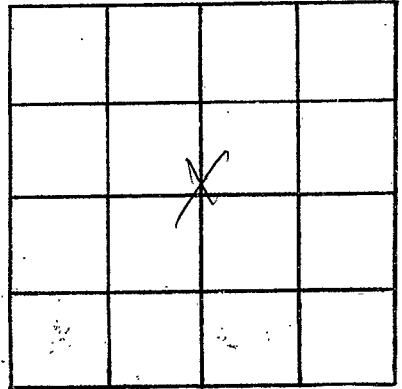

SECTION 10

Please indicate well location X.

ADDITIONAL INFORMATION

If more than one screen, show locations of each on sketch.