

DIKE
H 119
1-21-75

MISSISSIPPI
BOARD OF WATER COMMISSIONERS
416 North State Street
Jackson, Mississippi 39201 CODED

WATER WELL DRILLERS LOG

Jan. 21 1975 Chetco Pumps Pike
date well completed firm name county well located

LANDOWNER:
Harold Smith
Rt. 1 Mag.
(mailing address)

WELL LOCATION:
sec. 16 T. 2 N R. 8 E
3 miles east of Mag.
(distance) (direction) (nearest town)

WELL PURPOSE: Home
(home, irrigation, municipal, industrial)

WELL COMPLETION DATA:

(1) diameter (inches) 4

(2) total depth (feet) 799

(3) static water level (feet) 61 below above top of ground.

(4) casing plastic, 93,
(material) (depth)
1/2 if telescope see back.
(size)

(5) screen 6, 93
(length) (depth to top)
4", plastic
(size) (material)

(6) pump 2 1/2 hp, 6
(HP) (yield gpm)
1150
(type power)


(7) electric log no
(yes or no)

(organization running log)

description of formations encountered	from	to
<u>Red sand</u>		
<u>Clay</u>	<u>0</u>	<u>40</u>
<u>Pink Chalk</u>	<u>40</u>	<u>55</u>
<u>Sand & Gravel</u>	<u>55</u>	<u>76</u>
<u>Dark Chalk</u>	<u>76</u>	<u>84</u>
<u>Sand & Gravel</u>	<u>84</u>	<u>99</u>

(8) how well bottom plugged W. Thompson


DRILLERS REMARKS:
House Trailer

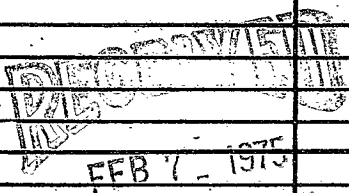

MISS. BD. OF WATER COMMISSIONERS

If well telescopes please sketch and show depths.

GROUND LEVEL

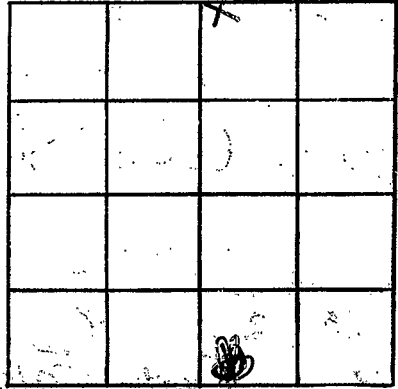

SECTION 16

Please indicate well location X.

ADDITIONAL INFORMATION

If more than one screen, show locations of each on sketch.