

PIKE
 H 120
 10-30-74

MISSISSIPPI
 BOARD OF WATER COMMISSIONERS
 416 North State Street
 Jackson, Mississippi 39201

CODED

WATER WELL DRILLERS LOG

Oct 30 1974 Chester River Pike
 date well completed firm name county well located

LANDOWNER:
Percy Elzey
Rt. 1 Magnolia
 (mailing address)

description of formations encountered	from	to
	<u>Clay & gravel</u>	<u>0</u>
<u>Sands & gravel</u>	<u>18</u>	<u>67</u>

WELL LOCATION:
 sec. 2 T. 20 N. R. 8 E.
 $\frac{1}{2}$ miles east of Magnolia
 (distance) (direction) (nearest town)

WELL PURPOSE: home
 (home, irrigation, municipal, industrial)

- WELL COMPLETION DATA:
- (1) diameter (inches) 4"
 - (2) total depth (feet) 67 1/2
 - (3) static water level (feet) 27 below top of ground.
 - (4) casing plastic bottom
 (material) (depth)
 - (size) if telescope see back.
 - (5) screen 6' 6 1/2'
 (length) (depth to top)
 - 4" plastic
 (size) (material)
 - (6) pump 1/2 10
 (HP) (yield gpm)
 - split
 (type power)
 - (7) electric log no
 (yes or no)
 - (organization running log)

(8) how well bottom plugged
wooden plug


DRILLERS REMARKS:
new house

CODED

FEB 28 1975
 MISS. RD. OF WATER COMMISSIONERS

If well telescopes please sketch and show depths.

GROUND LEVEL

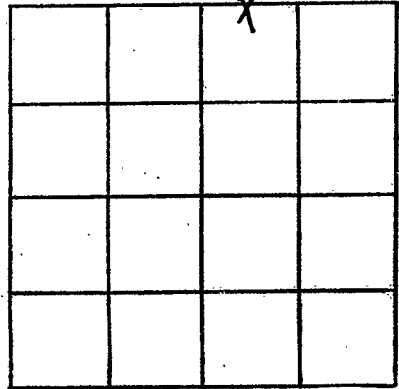

SECTION 97

Please indicate well location X.

ADDITIONAL INFORMATION

If more than one screen, show locations of each on sketch.