

PIKE
H121
3-20-75

MISSISSIPPI
BOARD OF WATER COMMISSIONERS
416 North State Street
Jackson, Mississippi 39201

CODED

WATER WELL DRILLERS LOG

March 20 1975 *Chuteo Pump* *Pike*
date well completed firm name county well located

LANDOWNER:
Mr. Fred Hayes
Rt Magnolia
(mailing address)


description of formations encountered	from to	
	feet	feet
<i>Red Clay</i>	<i>0</i>	<i>18</i>
<i>Chalk sand & gravel</i>	<i>18</i>	<i>60</i>
<i>Chalk sand & gravel</i>	<i>60</i>	<i>90</i>
<i>Chalk sand & gravel</i>	<i>90</i>	<i>106</i>

WELL LOCATION:
sec. *8* T. *2* N R. *8* E
2 1/2 miles *east* of *Magnolia*
(distance) (direction) (nearest town)

WELL PURPOSE: *home*
(home, irrigation, municipal, industrial)


- WELL COMPLETION DATA:
- (1) diameter (inches) *4*
 - (2) total depth (feet) *106*
 - (3) static water level (feet) *89* below top of ground
 - (4) casing *plastic bottom*
(material) (depth)
 - (size) If telescope see back.
 - (5) screen *6* *100*
(length) (depth to top)
 - 4"* *plastic*
(size) (material)
 - (6) pump *1/2 sub* *12*
(HP) (yield gpm)
 - Elect*
(type power)
 - (7) electric log (yes or no)
 - (organization running log)

(8) how well bottom plugged
no water etc
DRILLERS REMARKS:

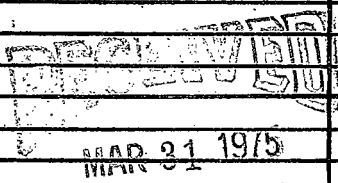

If well telescopes please sketch and show depths.

GROUND LEVEL

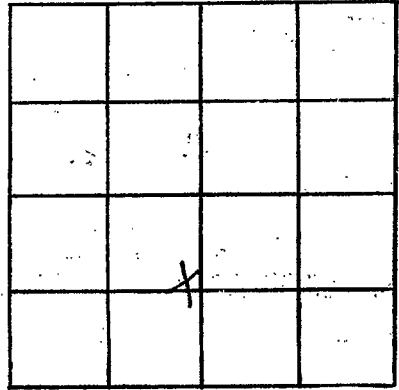

SECTION 8

Please indicate well location X.

ADDITIONAL INFORMATION

If more than one screen, show locations of each on sketch.