

PIKE
~~378~~ #122
 4-4-74

MISSISSIPPI
 BOARD OF WATER COMMISSIONERS
 416 North State Street
 Jackson, Mississippi 39201

CODED

WATER WELL DRILLERS LOG

April 4 1974 Chester Beenes Pike
 date well completed firm name county well located

LANDOWNER: Cora Magee
Rt. 2, McComb
 (mailing address)

description of formations encountered	from	to
<u>Red clay</u>	<u>0</u>	<u>20</u>
<u>Red sand</u>	<u>20</u>	<u>69</u>
<u>Sand & gravel</u>	<u>69</u>	<u>105</u>

WELL LOCATION:
 sec. 23 T 2 N R 8 E
12 miles ESE of Maple
 (distance) (direction) (nearest town)

WELL PURPOSE: Home
 (home, irrigation, municipal, industrial)

- WELL COMPLETION DATA:
- (1) diameter (inches) 4"
 - (2) total depth (feet) 105
 - (3) static water level (feet) 71 below top of ground.
 - (4) casing Plast bottom
 (material) (depth)
 - (size) if telescope see back.
 - (5) screen 6' 99'
 (length) (depth to top)
 - 10" Plast
 (size) (material)
 - (6) pump 1/2 sub 12
 (HP) (yield gpm)
 - elect
 (type power)
 - (7) electric log NO
 (yes or no)
 - (organization running log)
 - (8) how well bottom plugged wooden plug


DRILLERS REMARKS
old 2" well top

RECEIVED
 OCT 31 1974

MISSISSIPPI BOARD OF WATER COMMISSIONERS

If well telescopes please sketch and show depths.

GROUND LEVEL

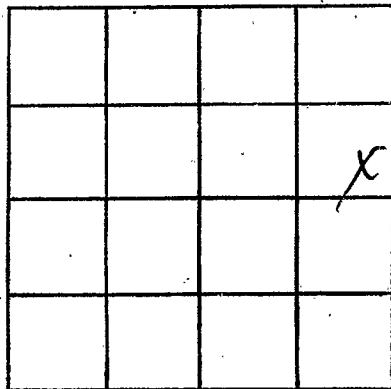

SECTION 12

Please indicate well location X.

ADDITIONAL INFORMATION

If more than one screen, show locations of each on sketch.