

PIKE
H 123
576
Elect # 123

MISSISSIPPI
BOARD OF WATER COMMISSIONERS
416 North State Street
Jackson, Mississippi 39201

COVERED

WATER WELL DRILLERS LOG

1976 GRINER DRILLING SERVICE PIKE
date well completed firm name county well located

LANDOWNER: EAST FERNWOOD
WATER ASSN. well No. 1
(mailing address)

description of formations encountered	from	to
Top Soil	0	3
SAND	3	20
SANDY CLAY	20	42
SAND + Gravel	42	180
SANDY CLAY	180	210
SAND + Gravel	210	338

WELL LOCATION: NW 1/4 SE 1/4 NE 1/4
sec. 3 T 2 N R 8 E S W

miles of (distance) (direction) (nearest town)


WELL PURPOSE: (home, irrigation, municipal, industrial)

WELL COMPLETION DATA:

- (1) diameter (inches) 8 5/8"
- (2) total depth (feet) 310'
- (3) static water level (feet) 95' below top of ground.
- (4) casing B.I. 253' (material) (depth) 8 5/8" (size) if telescope see back.
- (5) screen 40' 270' (length) (depth to top) (.010) 309 S.S. (size) (material)
- (6) pump 15 239 (HP) (yield gpm) Elect. (type power)
- (7) electric log Yes (part held) (yes or no) MGS (organization running log)

(8) how well bottom plugged BACK WASH VALVE

DRILLERS REMARKS:

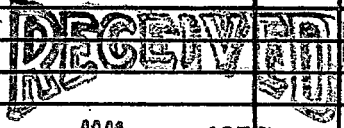


8 1976

MISS. RD. OF WATER COMM.

7

If well telescopes please sketch and show depths.

GROUND LEVEL

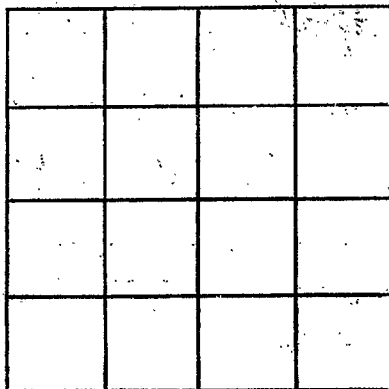

SECTION _____

Please indicate well location X.

ADDITIONAL INFORMATION

Lined area for additional information, consisting of 20 horizontal lines.

If more than one screen, show locations of each on sketch.