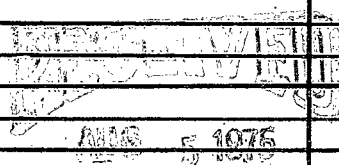


Pike
H 124
6-26-75


MISSISSIPPI
 BOARD OF WATER COMMISSIONERS
 416 North State Street
 Jackson, Mississippi 39201 CODED
 WATER WELL DRILLERS LOG

6-26 date well completed 1975 Fitzgerald Well Serv firm name Pike county well located

LANDOWNER:	description of fomations encountered	from	to
<u>Delas Butler</u>			
<u>R.H. Magnolia</u> (mailing address)	<u>Red Clay</u> <u>Red Sand</u> <u>Coarse-belt shale</u>	<u>6</u> <u>20</u> <u>150</u>	<u>20</u> <u>150</u> <u>160</u>
WELL LOCATION: sec. <u>20</u> T. <u>2</u> (N) R. <u>8</u> (E) ^{14 H} <u>3</u> miles <u>E</u> of <u>Magnolia</u> (distance) (direction) (nearest town)			
WELL PURPOSE: <u>Home</u> (home, irrigation, municipal, industrial)			
WELL COMPLETION DATA: (1) diameter (inches) <u>4</u> (2) total depth (feet) <u>160</u> (3) static water level (feet) <u>85</u> below above top of ground. (4) casing <u>plastic</u> , <u>152</u> , (material) (depth) <u>4</u> if telescope see back. (size) (5) screen <u>8</u> , <u>152</u> (length) (depth to top) <u>4</u> , <u>plastic</u> (size) (material) (6) pump <u>1/2</u> , <u>10</u> (HP) (yield gpm) <u>elec</u> (type power) (7) electric log <u>no</u> (yes or no) (organization running log) (8) how well bottom plugged <u>Sand plug</u>			
DRILLERS REMARKS:			

If well telescopes please
sketch and show depths.

GROUND LEVEL

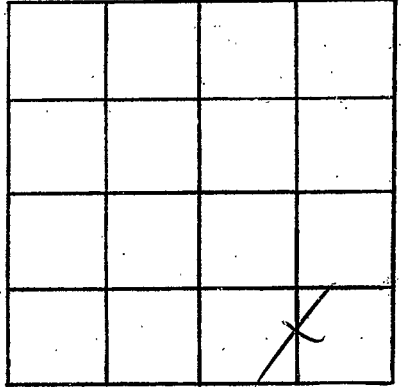

SECTION 20

Please indicate well location X.

ADDITIONAL INFORMATION

If more than one screen,
show locations of each on sketch.