

PEKE  
H 126

MISSISSIPPI  
BOARD OF WATER COMMISSIONERS  
416 North State Street  
Jackson, Mississippi 39201

CODED

WATER WELL DRILLERS LOG

1-9-81  
1-9  
date well completed

1981 *Sturdevant Well*  
firm name

*Peke*  
county well located


LANDOWNER:	description of formations encountered	from	to
<i>Laron Rayburn</i>			
<i>RR 2, Box 606</i> (mailing address)	<i>Red clay</i>	0	20
WELL LOCATION:	<i>Red sand</i>	20	124
sec. <u>36</u> T- <u>2</u> N S R- <u>8</u> E W	<i>Coarse sandstone</i>	124	134
<u>8</u> miles <u>E</u> of <u>MASSONIA</u> (distance) (direction) (nearest town)	<i>Red sand</i>	134	172
WELL PURPOSE: <u>IRR</u> (home, irrigation, municipal, industrial)	<i>Coarse sandstone</i>	172	188
WELL COMPLETION DATA:			
(1) diameter (inches) <u>4</u>			
(2) total depth (feet) <u>188</u>			
(3) static water level (feet) <u>85</u> below above top of ground.			
(4) casing <u>POC</u> , <u>124</u> , (material) (depth)			
<u>4</u> (size) if telescope see back.			
(5) screen <u>26</u> , <u>124</u> (length) (depth to top)			
<u>4</u> , <u>POC</u> (size) (material)			
(6) pump <u>5</u> <u>100</u> (HP) (yield gpm)			
<u>Elc</u> (type power)			
(7) electric log <u>no</u> (yes or no)			
<u>Landlth</u> (organization running log)			
(8) how well bottom plugged <u>Landlth</u>			
DRILLERS REMARKS:			

DEPT. OF NATURAL RESOURCES  
BUREAU OF LAND & WATER RESOURCES

JAN 29 1981  
RECEIVED

If well telescopes please sketch and show depths.

GROUND LEVEL

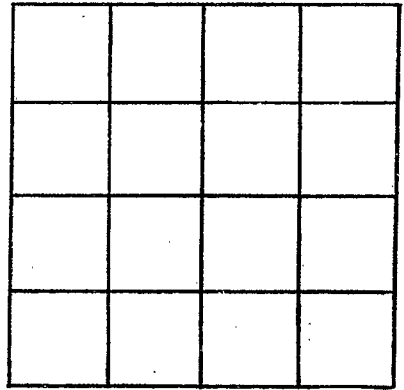

SECTION \_\_\_\_\_

Please indicate well location X.

ADDITIONAL INFORMATION

If more than one screen,  
show locations of each on sketch.