

Pike  
H27  
6-3-81

MISSISSIPPI  
BOARD OF WATER COMMISSIONERS  
416 North State Street  
Jackson, Mississippi 39201

**CODED**

WATER WELL DRILLERS LOG


6-3 1981 *Fitzgerald Well Serv* *Pike*  
date well completed firm name county well located

LANDOWNER:	description of formations encountered	from	to
<i>James Rayburn</i>			
<i>R.B. Mendenhall, Jr.</i> (mailing address)	<i>Red clay</i>	<i>0</i>	<i>20</i>
	<i>Red sand &amp; gravel</i>	<i>20</i>	<i>155</i>
	<i>Coarse sand &amp; gravel</i>	<i>155</i>	<i>180</i>

WELL LOCATION:  
sec. *36* T. *2* N. R. *8* E  
S  
*8* miles *E* of *Madison*  
(distance) (direction) (nearest town)

WELL PURPOSE: *IRR*  
(home, irrigation, municipal, industrial)


- WELL COMPLETION DATA:
- (1) diameter (inches) *4*
  - (2) total depth (feet) *180*
  - (3) static water level (feet) *75* below top of ground.
  - (4) casing *PVC*, *160*,  
(material) (depth)  
*4* if telescope see back.  
(size)
  - (5) screen *20*, *160*  
(length) (depth to top)  
*4*, *PVC*  
(size) (material)
  - (6) pump *5*, *100*  
(HP) (yield gpm)  
*elec*  
(type power)
  - (7) electric log *No*  
(yes or no)
  - (organization running log)
  - (8) how well bottom plugged *land fill*

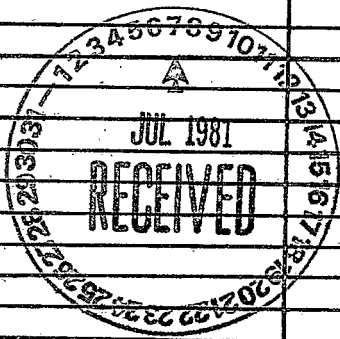

DRILLERS REMARKS:

If well telescopes please sketch and show depths.

GROUND LEVEL

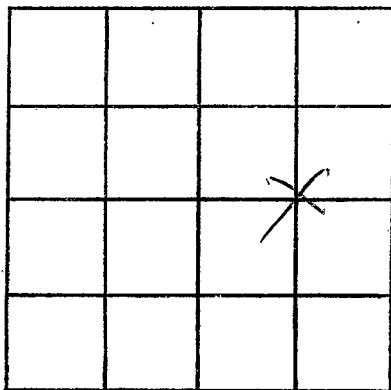

SECTION 36

Please indicate well location X.

ADDITIONAL INFORMATION

If more than one screen, show locations of each on sketch.