

MISSISSIPPI DEPARTMENT OF NATURAL RESOURCES

Bureau of Land and Water Resources

Southport Mall

P.O. Box 10631

CODED

Jackson, Mississippi 39209

WATER WELL DRILLERS LOG

Griner Drilling Service, Inc.

Pike

H143
Pike Co.
3-28-84

3-28-84 date well completed

Griner Drilling Service, Inc. firm name

Pike county well located

LANDOWNER:	description of formations encountered	from	to
See Land Drilling 900 Dunn Street Moumalala 70360 (mailing address)	clay	0	21
	sand	21	63
WELL LOCATION: 820'S 4 1823'E sec. 21 T. 2 N R. 8 E NW cor No. 11 mg Magnolia sterling et al (distance) miles (direction) of (nearest town)	gravel CODED	63	84
	SAND	84	105
WELL PURPOSE: oilfield supply (home, irrigation, municipal, industrial)	streaked clay	105	252
	SAND	252	336
<b>WELL COMPLETION DATA:</b>			
(1) diameter (inches) 3"			
(2) total depth (feet) 336'			
(3) static water level (feet) 30' below top of ground.			
(4) casing steel 336' (material) (depth)			
3" (size) if telescope see back.			
(5) screen 42' 294' (length) (depth to top)			
3" perforated (size) (material)			
(6) pump - 70 (HP) (yield gpm)			
AC (type power)			
(7) electric log (yes or no)			
(organization running log)			
(8) how well bottom plugged orange peel			
DRILLERS REMARKS:			


DEPT. OF NATURAL RESOURCES  
BUREAU OF LAND & WATER RESOURCES

APR - 6 1984

RECEIVED

If well telescopes please sketch and show depths.

GROUND LEVEL

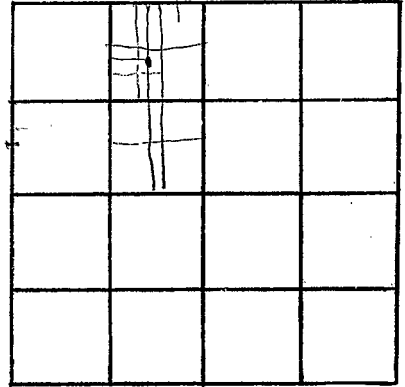

SECTION \_\_\_\_\_

Please indicate well location X.

ADDITIONAL INFORMATION

If more than one screen,  
show locations of each on sketch.