

MISSISSIPPI DEPARTMENT OF NATURAL RESOURCES

Bureau of Land and Water Resources

Southport Mall

P.O. Box 10631

Jackson, Mississippi 39209

WATER WELL DRILLERS LOG

CODED

H144  
 PIKE  
 4-30-84

4-30 1984 *Fitzgerald* *Pike*  
 date well completed firm name county well located

LANDOWNER: *Erroy Fisher*  
*R.R. Magnolia*  
 (mailing address)

description of formations encountered	from	to
<i>Red clay</i>	<i>2</i>	<i>20</i>
<i>Red sand</i>	<i>20</i>	<i>80</i>
<i>Coarse sand &amp; gravel</i>	<i>80</i>	<i>96</i>

WELL LOCATION:  
 sec. *35* T. *2* N. R. *8* E.  
*9* miles *E* of *Magnolia*  
 (distance) (direction) (nearest town)

WELL PURPOSE: *Home*  
 (home, irrigation, municipal, industrial)

WELL COMPLETION DATA:

(1) diameter (inches) *4*

(2) total depth (feet) *94*

(3) static water level (feet) *65* below top of ground.

(4) casing *PVC 86*,  
 (material) (depth)  
*4* if telescope see back.  
 (size)

(5) screen *8 86*  
 (length) (depth to top)  
*4* (size) *PVC* (material)

(6) pump *1/2 1/8*  
 (HP) (yield gpm)  
*elec* (type power)

(7) electric log *Yes*  
 (yes or no)  
 (organization running log)

(8) how well bottom plugged *Sealed*

DEPT. OF NATURAL RESOURCES  
 BUREAU OF LAND & WATER RESOURCES


JUN 15 1984

RECEIVED

DRILLERS REMARKS:

If well telescopes please sketch and show depths.

GROUND LEVEL

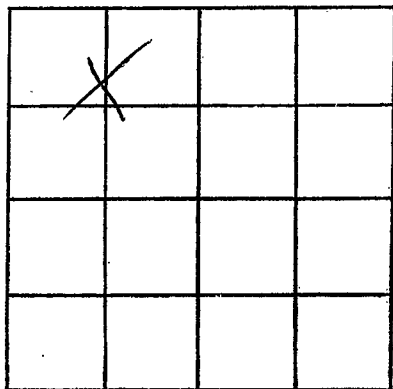

SECTION 35

Please indicate well location X.

ADDITIONAL INFORMATION

If more than one screen,  
show locations of each on sketch.