

PIKE  
H 147  
4-24-85

MISSISSIPPI DEPARTMENT OF NATURAL RESOURCES  
Bureau of Land and Water Resources  
Southport Mall  
P.O. Box 10631  
Jackson, Mississippi 39209  
**WATER WELL DRILLERS LOG**

4-24 1985 Fitzgerald Well Serv Pike  
date well completed firm name county well located

LANDOWNER: Snuffy Smith  
R.R. Magnolia ms.  
(mailing address)

description of formations encountered	from	to
<u>Red Clay</u>	<u>0</u>	<u>20</u>
<u>Red Sand</u>	<u>20</u>	<u>85</u>
<u>Coarse Sandstone</u>	<u>85</u>	<u>102</u>

WELL LOCATION:  
sec. 15 T 2 N R 8 E  
4 miles E of Magnolia  
(distance) (direction) (nearest town)

WELL PURPOSE: Home  
(home, irrigation, municipal, industrial)


- WELL COMPLETION DATA:
- (1) diameter (inches) 4
  - (2) total depth (feet) 102
  - (3) static water level (feet) 55 below above top of ground.
  - (4) casing PVC, 92,  
(material) (depth)  
4  
(size) if telescope see back.
  - (5) screen 10, 92  
(length) (depth to top)  
4, PVC  
(size) (material)
  - (6) pump 1/2, 10  
(HP) (yield gpm)  
El.  
(type power)
  - (7) electric log no  
(yes or no)  
(organization running log)
  - (8) how well bottom plugged Small blocks

RECEIVED  
MAY 17 1985

DRILLERS REMARKS:

If well telescopes please sketch and show depths.

GROUND LEVEL

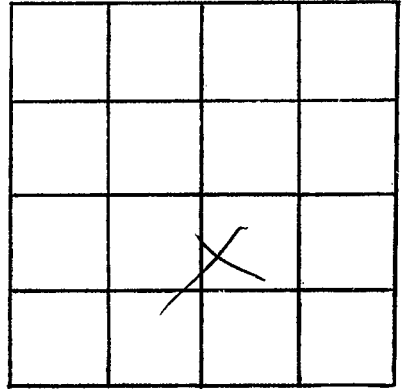

SECTION 15

Please indicate well location X.

ADDITIONAL INFORMATION

If more than one screen,  
show locations of each on sketch.