

MISSISSIPPI DEPARTMENT OF ENVIRONMENTAL QUALITY

Office of Land and Water Resources

P. O. Box 10631
Jackson, MS 39289-0631

WATER WELL DRILLERS LOG

COUNTY WELL LOCATED
Pike
WELL NUMBER
H-100
CODED
DATE WELL COMPLETED
7-25-03

PERMIT NUMBER
NAME OF DRILLING FIRM
Eitzgenald Well Service

NAME & MAILING ADDRESS OF LANDOWNER
Joel Allen
Biff Simmons Rd. Magnolia
Latitude:
Longitude:
WELL LOCATION. SEC TOWNSHIP RANGE
14 2 N 8 E
DISTANCE DIRECTION NEAREST TOWN
5 Miles East of Magnolia
OTHER LANDMARK
WELL PURPOSE: Home, Irrigation, Municipal, Industrial, Fish Pond, etc.
Chicken House Well

PUMP DATA

PUMP TYPE (Circle One):
Submersible Turbine, Jet, Flowing Well,
Other (Describe)
POWER TYPE (Circle One):
Electric, Tractor, Diesel, Gasoline, Butane,
Other (Describe) H/P 3

DESCRIPTION OF FORMATIONS ENCOUNTERED	FROM	TO
clay	0	30
Sand	30	80
gravel	80	90
clay	90	110
Sand	110	130
course sand	130	150

WELL DATA

Well Depth 150 Casing Diameter (In.) 4" Casing Length (Ft.) 130'
Type of Casing PVC Hole Depth 150 Depth to Static Water Level 87'

TYPE OF COMPLETION: (Circle One or More):
Gravel Packed Underreamed, Telescoped,
Natural Development, Open Hole, Other
(Describe)

WELL GROUTED TO A DEPTH OF 10 FEET
Type Grout (circle one): Cement, Bentonite, or Mix

SCREEN DATA

Diameter - inches 4" Length - Feet 20 Slot Size - inches 010/012
Screen Type PVC Depth to Bottom - Feet 150'

Top of Lap Pipe or Reduction in Casing
FEET IF TELESKOPED OR MORE THAN ONE SCREEN: USE BACK PAGE

RECEIVED
AUG 18 2003
BY: OLWR

I certify that the well was drilled, constructed and completed in accordance with all applicable Requirements of the Mississippi Department of Environmental Quality and/or the Mississippi Department of Health regulations and state laws.


Bead Styzenski 029
Signature of Licensed Driller and License No.

7-25-03
Date

Additional Information Required On Back

If well telescopes please sketch and show depths.

GROUND LEVEL

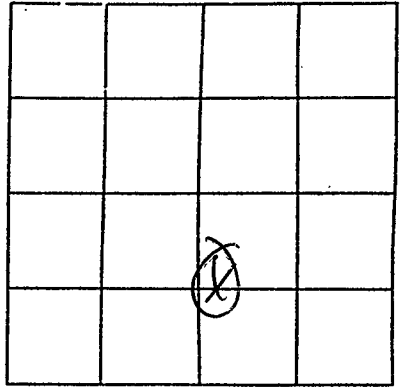

SECTION 14

Please indicate well location X.

Pump Capacity (GPM)	No. of Stages	Setting Depth
<u>35</u>		<u>120'</u> FT.

PUMP TEST

Well yielded _____ GPM with
a drawdown of _____ ft.
after _____ hours of pumping

LOG DATA

TYPE OF LOG RUN (Circle One): No Log Run, Electric, Gamma Ray, Density, Sonic, Neutron, Other (Describe) _____

Name of Organization Running Log _____

GEOLOGIC DATA (Office Use Only)

Surface Elev.	Geologic Unit	Unit Thickness	Depth to Top
Subs. SWL	Date	Analysis	Aquifer Test

Driller's Remarks

If more than one screen, show location of each on sketch.