
art 2 never received	State wen Report	For Office Use Only:
County: Pike	Part 1 – Driller's Log	
	Mississippi Department of Environmental Quality	Aquifer:
Permit #:	Office of Land and Water Resources P.O. Box 10631	Well #: 17 - 179
Driller: Fitzgera & Well Seven	Jackson, MS 39289-0631	L. S. Elevation:
Date drilling completed: <u>9-19-05</u>	(601)961-5210	L. S. Elevation:
	(601)354-6938 (fax)	E-log #:
State Law requires that this repor Department at the above address Information on Well (	t be prepared by the license holder responsible for within 30 days of completion of drilling of the we	the work and filed with the ll or borehole. Borehole Location
(Landowner if borehole is not fo	or a water well)	
	Latitude 3 ° Olo '09	" Longitude: <u>10 °22 '37</u> "
Dwner Name Guy Sherman	0 Method of Lat/Long (circle	one): Conventional Survey
Mailing Address: Beila chife	Kd (Citer	oney. Conventional Survey,
		d GPS, Survey-grade GPS
1	SW 1/ SW 1/ Ser 31	5 Twn 2N Rng 8E
Magnoliz M	26	
City Sta	te Zip Code Distance Direction	of Magnoline
Telephone No. ()	Miles ETS	or magnetit
······································		
	Well / Borehole Data	
Date drilling started: 9-19-05 Date dr	illing completed: <u>9-19-05</u> Hole depth: 70-	Hole diameter: 811
Location of the source of any surface water Method of desing and volume of Chloring	er used for drilling:	
Logs run (circle all applicable): (No log run Name of organization running log <del>(s):</del>	Electric Gamma Ray Density Sonic Neutron	Other:
Purpose of borehole (check one): Water W	ell Ceotechnical/Geological Investigation Grour	nd Source Heat Pump
Coinnia (	Survey Other (describe)	
If drilling is not related	SurveyOther (describe) to water well construction, skip the remainder of this b	lock
	/	
rurpose of well (check one): Home 🖉 I	ndustrial Public Supply Irrigation Fish Culture	e Other:
If a flowing well, method of flow regulation	n: Valve Other (describe)	Dre
	ove or below (circle one) land surface Date measured	RLOP
	$\sim$	Cro
Method of Measurement (circle one)	el tape electric tape air line other:	SEP 30
Well depth: 70 Well grouted to a de	pth of feet Type of grout (circle one): Neat Ce	ment Bentonite BV. OI
	Type of grout (circle one). Weat Ce	
Casing length: 60 feet Casir	inches Type of casing:	pvc
Screen length: 10 feet Scree	en diameter: $\underline{\mathcal{U}^{\prime\prime}}_{inches}$ Type of screen: _	Ave
	Setting depth: From <u>60</u> feet to	
inches	Setting depth: Fromfeet to	feet
Type of completion (circle all applicable):	Gravel packed Underreamed Telescoped Ope	n hole Natural Development
	Other (describe):	
Top of lap pipe or reduction in casing:	feet. If telescoped or more than one scr	een, describe on next page
1 .		Form: OLWR-SWR-1A
outed Evon Gravel Pack	to ground level. Hand pump in well.	
1		
Home some to set A	- Hand pump in well.	
<u> </u>		


## The sketch below only required for water wells

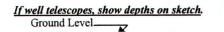

Description of formations encountered must be provided for all wells and boreholes, unless specifically exempted by regulations

From (depth)	To (depth)
Ground Level	
$\bigcirc$	15
15	20
20	40
40	60
60	70
	From (depth) Ground Level Groun

If more than one screen, show location of each on sketch

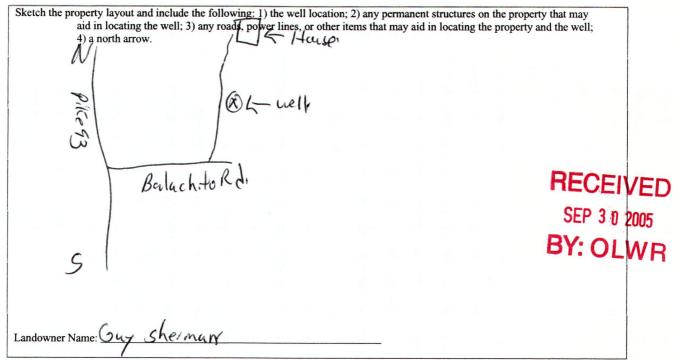

Form: OLWR-SWR-1A

I certify that the well/borehole was drilled, constructed, and completed in accordance with all applicable requirements of the Mississippi Department of Environmental Quality and the Mississippi Department of Health regulations, if applicable, and state

Date

laws Fitzgera BIAN

Print Name of Responsible Licensee and License No.

Signature of Licensee