Part 2 never received County: Pike	D		For Office Use Only:
County: Fire	Permit # Frenald Well Surce Mississippi Department of Environmental Quality Office of Land and Water Resources		Aquifer: H 2/7
Permit #: Fitzerald Well Severe			
Driller: 10-14-10 Fitzgerald	P.O.	Box 2309 n, MS 39225	Well #:
Date drilling completed: 10-14-10,	(601))961- 5210	L. S. Elevation:
Date drilling completed:(601)961- 5228 (fax)			E-log #:
State Law requires that this repo	」 rt he prepared by the lic	ense halder responsible for i	
Department at the above address			
		rehole Location	
(Landowner if borehole is not for a water well)		Latitude: 31 ° 5 . 19.	2." Longitude 90° 21', 21.9
Owner Name Wallace milcenze.			
Mailing Address: Enerald Lune:		Method of Lat/Long (circle one): Conventional Survey, USGS guad. Hand-held GPS, Survey-grade GPS	
<u>Magnilly</u> MS City Sta			
City Sta	te Zip Code	Distance Direction Miles	Nearest Town
Telephone No. ()			VI
· · · · · · · · · · · · · · · · · · ·	Well / Bore	L	
			C #
Date drilling started: 10-14-10 Date dr	illing completed: <u>0-19</u>	-10 Hole depth: 136	Hole diameter:
Location of the source of any surface wat	er used for drilling:		
Method of dosing and volume of Chlorin			
Logs run (circle all applicable): No log run Name of organization running log(s):		Density Sonic Neutron	
Purpose of borchole (check one): Water W	ell Ccotechnical/Geol	logical Investigation Ground	Source Heat Pump
Seismic	Survey Other (describe	?)	
If drilling is not related	to water well constructio	m, skip the remainder of this blo	ock
Purpose of Well (check one): Home	ndustrial Public Sunnly	v Irrigation Fish Culture	Other:
		-	
If a flowing well, method of flow regulation $\int c c dt$			
Static Water Level: <u>69</u> feet at	ove or below (circle one) l	land surface Date measured: (0-14-10
	cel tape electric tape	air line other:	
Well depth: 136 Well grouted to a de	pth of <u>IU</u> feet Type	of grout (circle one) Neat Cem	ent Bentonite Mix
Casing length:feet Casin	ng diameter: <u>4"</u>	inches Type of casing:	pic
Screen length: <u>JU</u> feet Scre	en diameter: Y'	inches Type of server	pu
Screen slot size:inches	Setting depth: From	116 feet to 3	16 feet
Type of completion (circle all applicable):	Gravel packed Under	reamed Telescoped Open	hole Natural Development
	Other (describe):		
Top of lap pipe or reduction in casing:	feet. If tel	escoped or more than one scree	<u>n, describe on next page</u>
Top of lap pipe or reduction in casing:			<u>n, describe on next page</u> Form: OLWR-SWR-1A (04/
			-

. .


RECEIVED OCT 1 9 2010 BY: OLWF

The sketch below only required for water wells

If well telescopes, show depths on sketch. Ground Level Description of formations encountered must be provided for all wells and boreholes, unless specifically exempted by regulations

	Description of Formations Encountered		To (depth)
·····		Ground Level	
	Claye	0	20
	cluby.	20	40
	grank!	40	60
	sund	60	80
	<u> </u>	80	80
	Sandr	10	100
	Sandr Sandr Cunge Sand	100	116
	Cuuze Sand	116	136
			1
			+
		-	
		1	I

If more than one screen, show location of each on sketch

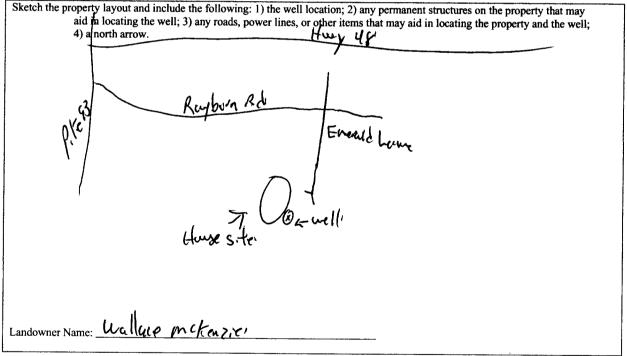

Form: OLWR-SWR-1A (04/08)

I certify that the well/borehole was drilled, constructed, and completed in accordance with all applicable requirements of the Mississippi Department of Environmental Quality and the Mississippi Department of Health regulations, if applicable, and state

Date

laws KIAC F. ald

1674-10

Print Name of Responsible Licensee and License No.

Signature of Licensee

RECEIVED OCT 1 9 2010 BY: OLWR