

# STATE WELL REPORT

## Part 1

### Driller's Log

Mississippi Department of Environmental Quality  
Office of Land and Water Resources  
P.O. Box 2309  
Jackson, MS 39225-2309  
(601)961-5210  
(601)360-0535 (fax)

#### For Office Use Only:

Well #: H234  
Aquifer: \_\_\_\_\_  
E-Log #: \_\_\_\_\_

County: Pike  
Permit #: \_\_\_\_\_  
Driller: Fitzgerald Well  
Date drilling completed: 6/5/14

*State Law requires that this report be prepared by the license holder responsible for the work and filed with the Department at the above address within 30 days of completion of drilling of the well or borehole.*

Well Owner Information (Landowner if borehole is not for a water well)	Well or Borehole Location
Owner Name: <u>Dewayne Dunaway</u>	Latitude: <u>31°5'17.2"</u> Longitude: <u>90°22'25.8"</u> <span style="margin-left: 100px;"><small>17</small></span> <span style="margin-left: 100px;"><small>26</small></span>
Mailing Address: <u>Williams Rd</u>	Method of Lat/Long (check one): Conventional Survey _____
	USGS quad _____, Hand-held GPS _____, Survey-grade GPS _____
<u>Magnolia</u> <u>MS</u> City State Zip Code	<u>SE 1/4 SW 1/4, Sec 35 T 2N R 8E</u>
Telephone No. (____) _____	_____ Miles _____ of _____ (Distance) (Direction) (Nearest Town)

#### Well / Borehole Data

Date drilling started: 6/5/14 Date drilling completed: 6/5/14 Hole depth: 70 Hole diameter: 8"  
Location of the source of any surface water used for drilling: \_\_\_\_\_  
Method of dosing and volume of Chlorine used in drilling and development: \_\_\_\_\_  
Logs run (circle all applicable):  No log run  Electric  Gamma Ray  Density  Sonic  Neutron Other: \_\_\_\_\_  
Name of organization running log(s): \_\_\_\_\_  
Purpose of borehole (circle one):  Water Well  Geotechnical/Geological Investigation  Ground Source Heat Pump  
 Seismic Survey Other (describe) \_\_\_\_\_

*If drilling is not related to water well construction, skip the remainder of this block*

Purpose of Well (circle all applicable):  Home  Industrial  Public Supply  Irrigation  Fish Culture  
Other (describe): \_\_\_\_\_  
If a flowing well, method of flow regulation: Valve \_\_\_\_\_ Other (describe) \_\_\_\_\_  
Static Water Level: 44 feet [above or below] land surface Date measured: 6/5/14  
(circle one)  
Method of measurement (circle one):  Steel tape  Electric tape  Air line Other (describe): \_\_\_\_\_  
Well depth: 70 Well grouted to a depth of: 10 feet Type of grout (circle one):  Neat Cement  Bentonite  Mix  
Casing length: 60 feet Casing diameter: 4" inches Type of casing: PVC  
Screen length: 10 feet Screen diameter: 4" inches Type of screen: PVC  
Screen slot size: 0.012 inches Setting depth: From 60 feet to 70 feet  
Type of completion (circle all applicable):  Gravel packed  Underreamed  Open hole  Natural Development  
Other (describe): \_\_\_\_\_  
Top of lap pipe or reduction in casing: \_\_\_\_\_ feet

*If telescoped or more than one screen, describe on next page*


Received  
JUN 16 2014  
BY OLWR

H234

*The sketch below only required for water wells*

*If well telescopes, show depths on sketch.*

Ground Level

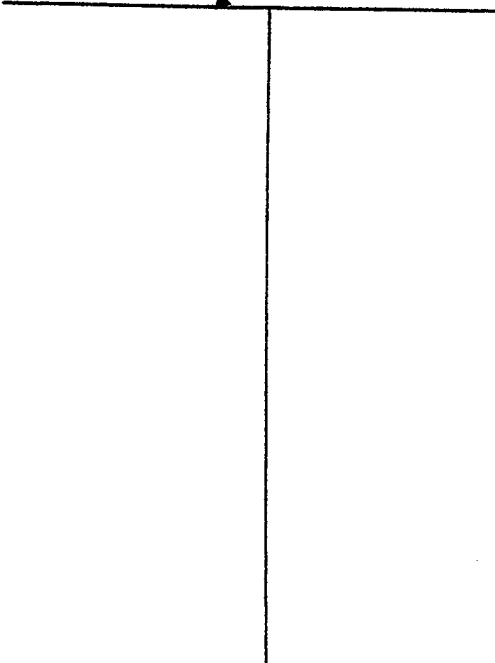


*Description of formations encountered must be provided for all wells and boreholes, unless specifically exempted by regulations*

Description of Formations Encountered	From (depth)	To (depth)
	Ground Level	
Clay	0	20
Sand + Gravel	20	50
Sand	50	60
Coarse Sand	60	70

If more than one screen, show location of each on sketch

Sketch the property layout and include the following: 1) the well location; 2) any permanent structures on the property that may aid in locating the well; 3) any roads, power lines, or other items that may aid in locating the property and the well; 4) a north arrow.

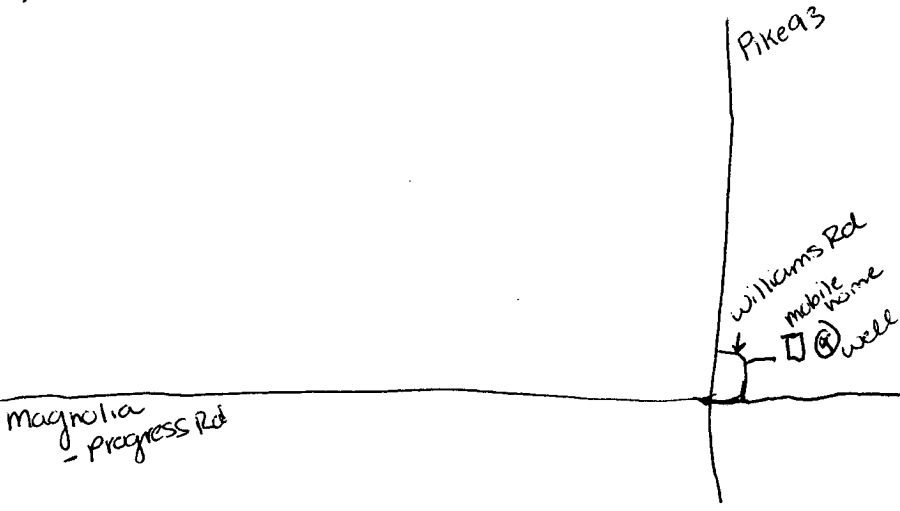

**Received**  
JUN 16 2014  
**BY OLWR**

Landowner Name: Dewayne Dunaway

Form: OLWR-SWR-1A (04/08)

I certify that the well/borehole was drilled, constructed, and completed in accordance with all applicable requirements of the Mississippi Department of Environmental Quality and the Mississippi Department of Health regulations, if applicable, and state laws.

Paul Fitzgerald 024.      6-5-14.

Print Name of Responsible Licensee and License No.      Date

Paul Fitzgerald

Signature of Licensee

# STATE WELL REPORT

## Part 2

**Pump Installer's Completion Report**  
Mississippi Department of Environmental Quality  
Office of Land and Water Resources  
P.O. Box 2309  
Jackson, MS 39225-2309  
(601)961-5210  
(601) 360-0535 (fax)

### For Office Use Only:

Well #: H234  
Aquifer: \_\_\_\_\_

County: Pike  
Permit #: \_\_\_\_\_  
Driller: Fitzgerald Well  
Date completed: 6/5/14  
**Copy information from block on Part 1**

*This part of the report must be completed by a licensed water well contractor or a licensed pump installer. A copy of Part 1 of the report must be attached and both parts filed with the Department at the above address within 30 days of well completion.*

Well Owner Information	Well Location
Owner Name: <u>Dwayne Dunaway</u>	Latitude: <u>31° 5' 17.2"</u> Longitude: <u>90° 22' 25.8"</u>
Mailing Address: <u>Williams Rd</u>	Method of Lat/Long (check one): Conventional Survey _____
<u>Magnolia</u> MS	USGS quad _____, Hand-held GPS _____, Survey-grade GPS _____
City State Zip Code	<u>SE 1/4 SW 1/4, Sec 35 T 2N R 8E</u>
Telephone No. (____) _____	____ Miles of _____ (Distance) (Direction) (Nearest Town)

### Pump Type (circle one)

Submersible  Turbine  Air Lift  Centrifugal  Flowing Well  Jet  Piston  Rotary  Other (describe): \_\_\_\_\_  
Date Pump Installed: 6/5/14 Rated Pump Capacity: 12 Gallons Per Minute  
Is This Pump (circle one):  New  Repaired  Replacement

### Power Type (circle one)

Electric  Diesel  Gasoline  Natural Gas  Tractor PTO  Windmill  Other (describe): \_\_\_\_\_  
Horse Power Rating of Motor: 3/4 Setting Depth: 65 feet Number of Stages: 12

### Pump Test Data for Non Flowing Well

Date Well Tested: \_\_\_\_\_ Duration of Pump Test (minimum 4 hours): \_\_\_\_\_ hours  
Static Water Level (A): \_\_\_\_\_ Feet Below Land Surface Pumping Water Level (B): \_\_\_\_\_ Feet Below Land Surface  
Drawdown [(B) - (A)]: \_\_\_\_\_ Feet Below Land Surface Test Pumping Rate: \_\_\_\_\_ Gallons Per Minute  
Method of measurement (circle one): Steel tape  Electric tape  Air line  Other (describe): \_\_\_\_\_

### Pump Test Data for Flowing Well

Measured shut in head: \_\_\_\_\_ feet.  
Well yielded \_\_\_\_\_ GPM with a drawdown of \_\_\_\_\_ feet after \_\_\_\_\_ hours of pumping

### Meter Installation

Meter Manufacturer: \_\_\_\_\_ Meter Serial Number: \_\_\_\_\_ **Received**  
Meter Model Number/Name: \_\_\_\_\_ Type of Meter: \_\_\_\_\_ **JUN 16 2014**  
Totalizer Register Unit and Multiplier Factor (AF x .001, gal x 1000, etc): \_\_\_\_\_ **BY OLWR**  
Installation Date: \_\_\_\_\_ Meter installed by: \_\_\_\_\_  
Is This Meter (circle one):  New  Repaired  Replacement

**Important: By submitting the above information you are certifying that this meter was installed to manufacturer standards. For agricultural wells, a list of approved meters is on the MDEQ website.**

I HEREBY CERTIFY that the above statements are true to the best of my knowledge.

Brad Fitzgerald 029 6-5-14 Red Hill  
Print Name of Pump Installer and License No. (if applicable) Date Signature of Pump Installer