

Pike Co
H 2000
3-18-70

MISSISSIPPI
BOARD OF WATER COMMISSIONERS
416 North State Street
Jackson, Mississippi 39201

CODED

WATER WELL DRILLERS LOG

March 18 1970 Keene Well Drilling Co. Pike
date well completed firm name county well located

LANDOWNER: Wm Lang
Rt-1, Magnolia

description of formations encountered

from to

Red clay	0	19
Red sand	19	42
Sand-gravel-chalk	42	81
gravel	81	95

(mailing address)

WELL LOCATION:

sec. 4 T. 20 N. R. 6 E
5 miles (distance) E (direction) of Magnolia (nearest town)

WELL PURPOSE: Home
(home, irrigation, municipal, industrial)

WELL COMPLETION DATA:

(1) diameter (inches) 1 1/2"
(2) total depth (feet) 95
(3) static water level (feet) 65 below top of ground.
(4) casing Plastic Bottoms (material) (depth)

CODED

(5) screen Plastic Bottoms (length) (depth to top)
4' (size) Plastic (material)

(6) pump 1/2 sub 1/2 (HP) (yield gpm)
elect. (type power)

(7) electric log NO (yes or no)

(organization running log)

(8) how well bottom plugged wooden plug

MAR 23 1970


DRILLERS REMARKS:

new location
House Trailer

MISS. Bd. OF WATER COMM.

If well telescopes please sketch and show depths.

GROUND LEVEL

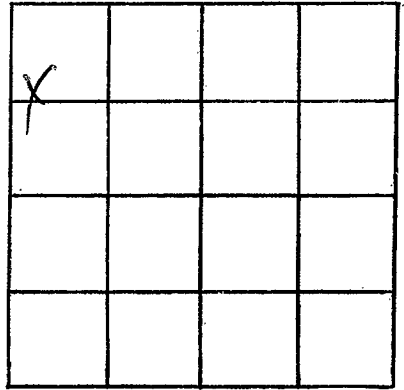

SECTION 11

Please indicate well location X.

ADDITIONAL INFORMATION

If more than one screen,
show locations of each on sketch.