

Pike
 H 2001
 9-30-75

MISSISSIPPI
 BOARD OF WATER COMMISSIONERS
 416 North State Street
 Jackson, Mississippi 39201

WATER WELL DRILLERS LOG

Sept. 30 1975 New Well Service Pike
 date well completed firm name county well located

LANDOWNER:
Rommel Butler
At. Magnolia
 (mailing address)

description of formations encountered	from	to
	Clay	0
Chalky sand	4	60
sand & pebbles	60	120

WELL LOCATION:
 sec 36 T 2N R 7E
4 1/2 miles South of Magnolia
 (distance) (direction) (nearest town)

WELL PURPOSE: home
 (home, irrigation, municipal, industrial)


- WELL COMPLETION DATA:
- (1) diameter (inches) 4"
 - (2) total depth (feet) 120
 - (3) static water level (feet) 70 below above top of ground.
 - (4) casing Plaster, bottom
(material) (depth)
 - If telescope see back.
(size)
 - (5) screen 6' 114
(length) (depth to top)
 - 1/2" Plaster
(size) (material)
 - (6) pump 1/2 HP 10
(HP) (yield gpm)
 - elect
(type power)
 - (7) electric log no
(yes or no)
 - (organization running log)
 - (8) how well bottom plugged all water plug

DRILLERS REMARKS:

REC'D
 JAN 12 1976
 MISS. BU. OF WATER

If well telescopes please sketch and show depths.

GROUND LEVEL

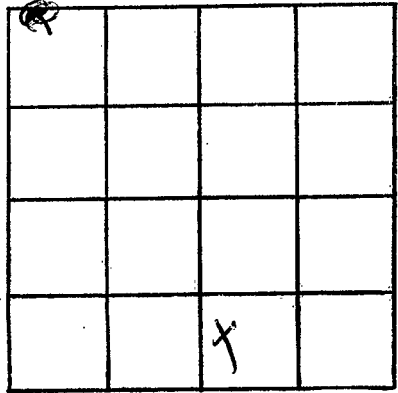

SECTION 36

Please indicate well location X.

ADDITIONAL INFORMATION

If more than one screen,
show locations of each on sketch.