

PIKE
H 2004
12-27-75

MISSISSIPPI
BOARD OF WATER COMMISSIONERS
416 North State Street
Jackson, Mississippi 39201

WATER WELL DRILLERS LOG

Dec 27 1975 *Rever Well Service* *Pike*
date well completed firm name county well located

LANDOWNER: *Mr. E. Leroy Brown*
RT 1 *Magnolia*
(mailing address)

description of formations encountered	from	to
<i>clay</i>	<i>0</i>	<i>18</i>
<i>red sand</i>	<i>18</i>	<i>82</i>
<i>granite sand</i>	<i>82</i>	<i>104</i>


WELL LOCATION:
sec. *10* T *2* N R *8* E
4 miles *east* of *Magnolia*
(distance) (direction) (nearest town)

WELL PURPOSE: *Trailer*
(home, irrigation, municipal, industrial)

- WELL COMPLETION DATA:
- (1) diameter (inches) ~~10~~ *4"*
 - (2) total depth (feet) *104*
 - (3) static water level (feet) *73* below top of ground.
 - (4) casing *plaster bottom*
(material) (depth)
 - (size) If telescope see back.
 - (5) screen *6'* *98*
(length) (depth to top)
 - 1 1/2"* *plaster*
(size) (material)
 - (6) pump *3 Sub* *12*
4 (HP) (yield gpm)
 - elect*
(type power)
 - (7) electric log *no*
(yes or no)
 - (organization running log)


(8) how well bottom plugged
Washed plug

DRILLERS REMARKS:
New Trailer Site

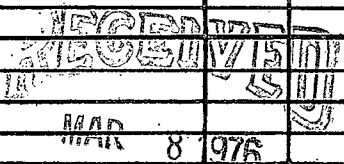

If well telescopes please sketch and show depths.

GROUND LEVEL

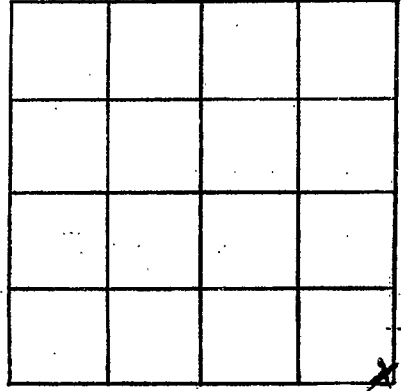

SECTION 10

Please indicate well location X.

ADDITIONAL INFORMATION

If more than one screen, show locations of each on sketch.