

PIKE
N 2005
1-14-76

MISSISSIPPI
 BOARD OF WATER COMMISSIONERS
 416 North State Street
 Jackson, Mississippi 39201

WATER WELL DRILLERS LOG

14 Jan 1976 Jet-Corrupter Pike
 date well completed firm name county well located


LANDOWNER:	description of formations encountered	from	to
<u>Rostan Williams</u>	<u>clay</u>	<u>0</u>	<u>25</u>
<u>Magalia</u> (mailing address)	<u>clay</u>	<u>25</u>	<u>45</u>
	<u>sand</u>	<u>45</u>	<u>65</u>
	<u>sand</u>	<u>65</u>	<u>85</u>
	<u>sand</u>	<u>85</u>	<u>122</u>

DECEMBER 1975

MAR 26 1976

If well telescopes please sketch and show depths.

GROUND LEVEL

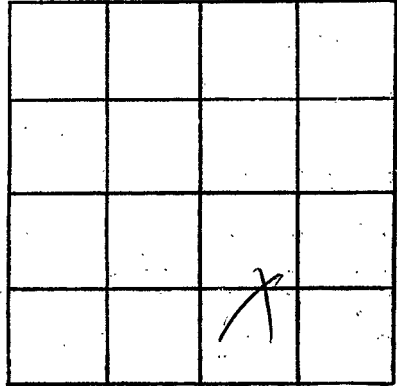

SECTION 5

Please indicate well location X.

ADDITIONAL INFORMATION

If more than one screen, show locations of each on sketch.