

Pike
H 2000
4/30/76

MISSISSIPPI
 BOARD OF WATER COMMISSIONERS
 416 North State Street
 Jackson, Mississippi 39201

WATER WELL DRILLERS LOG

April 30 1976 Premier Well Service Pike
 date well completed firm name county well located

LANDOWNER:
Henson Children's
Pct. 1 - Magnolia
 (mailing address)

description of formations encountered	from	to
<u>Red Clay</u>	<u>0</u>	<u>12</u>
<u>Silt Sand</u>	<u>12</u>	<u>50</u>
<u>Sand & Gravel</u>	<u>50</u>	<u>60</u>
<u>Pink Chalk</u>	<u>60</u>	<u>65</u>
<u>Sand & gravel</u>	<u>65</u>	<u>72</u>

WELL LOCATION:
 sec. 16 T 2 N R 9 E
4 miles east of Magnolia
 (distance) (direction) (nearest town)

WELL PURPOSE: Fountain
 (home, irrigation, municipal, industrial)

WELL COMPLETION DATA:

(1) diameter (inches) 1 1/2"

(2) total depth (feet) 72

(3) static water level (feet) 60 below above-top of ground.

(4) casing plastic bottom
 (material) (depth)

1 if telescope see back.
 (size)

(5) screen 6' 86'
 (length) (depth to top)

1/2" plastic
 (size) (material)

(6) pump weathers
 (HP) (yield gpm)


elect
 (type power)

(7) electric log no
 (yes or no)

 (organization running log)

(8) how well bottom plugged wooden plug

DRILLERS REMARKS:
no remarks

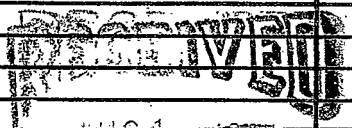


AUG 16 1976

MISS. BR. OF WATER COMMISSIONERS

If well telescopes please sketch and show depths.

GROUND LEVEL

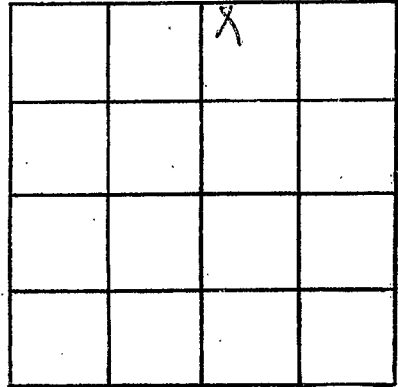

SECTION 16

Please indicate well location X.

ADDITIONAL INFORMATION

If more than one screen, show locations of each on sketch.