

PIKE

2008

8-30-78

MISSISSIPPI  
 BOARD OF WATER COMMISSIONERS  
 416 North State Street  
 Jackson, Mississippi 39201

WATER WELL DRILLERS LOG

8-30  
date well completed

1978 *F. J. ...*  
firm name

*Pike*  
county well located

LANDOWNER:

*McCarlie*

*Jane McCarlie*

*R.R. ...*  
(mailing address)

description of formations encountered

from

to

<i>Red Clay</i>	0	20
<i>Red sand clay</i>	20	95
<i>Green sand &amp; gravel</i>	95	103

WELL LOCATION:

sec. 6 T. 2 N R. 8 E  
 S W  
1 miles SE of Geniwood  
 (distance) (direction) (nearest town)

WELL PURPOSE:

(home, irrigation, municipal, industrial)

WELL COMPLETION DATA:

- (1) diameter (inches) 4
- (2) total depth (feet) 103
- (3) static water level (feet) 45 below top of ground.
- (4) casing PVC 95  
(material) (depth)  
4 if telescope see back.  
(size)
- (5) screen 8 95  
(length) (depth to top)  
4 PVC  
(size) (material)
- (6) pump 1/2 10  
(HP) (yield gpm)  
elec  
(type power)
- (7) electric log yes  
(yes or no)  
(organization running log)
- (8) how well bottom plugged sealed


RECEIVED

OCT 3 1978

DRILLERS REMARKS:

If well telescopes please sketch and show depths.

GROUND LEVEL

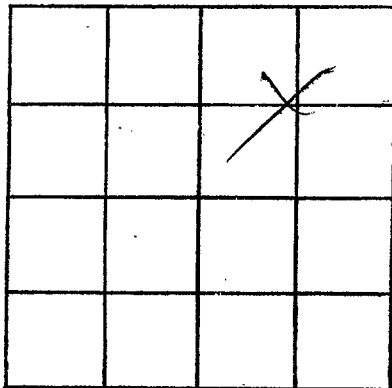

SECTION 6

Please indicate well location X.

ADDITIONAL INFORMATION

If more than one screen, show locations of each on sketch.