

PIKE
H 200A
8-31-78

**MISSISSIPPI  
BOARD OF WATER COMMISSIONERS**  
416 North State Street  
Jackson, Mississippi 39201

**WATER WELL DRILLERS LOG**

8-31 date well completed      1978 *F. S. ...* firm name      *Pike* county well located

**LANDOWNER:**  
*Ed Leblanc*  
*R.R. ... MS*  
(mailing address)

description of formations encountered	from	to
<i>Red clay</i>	<i>0</i>	<i>20</i>
<i>Red sand</i>	<i>20</i>	<i>80</i>
<i>Red sand</i>	<i>80</i>	<i>110</i>
<i>Coarse sand &amp; gravel</i>	<i>110</i>	<i>146</i>

**WELL LOCATION:**  
sec. *12* T-*2* N R-*8* E  
S W  
*9* miles *E* of *Farmwood*  
(distance) (direction) (nearest town)

**WELL PURPOSE:** *Home*  
(home, irrigation, municipal, industrial)

**WELL COMPLETION DATA:**

(1) diameter (inches) *4*

(2) total depth (feet) *146*

(3) static water level (feet) *100* below above top of ground.

(4) casing *40 C 138*  
(material) (depth)  
*4* (size) if telescope see back.


(5) screen *8 138*  
(length) (depth to top)  
*4* (size) (material) *40 C*

(6) pump *12 10*  
(HP) (yield gpm)  
*Elc* (type power)

(7) electric log *Yes*  
(yes or no)  
(organization running log)

(8) how well bottom plugged *Full plug*


**DRILLERS REMARKS:**

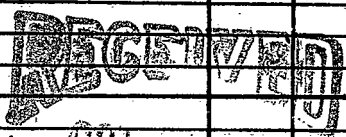

OCT 3 1978

If well telescopes please sketch and show depths.

GROUND LEVEL

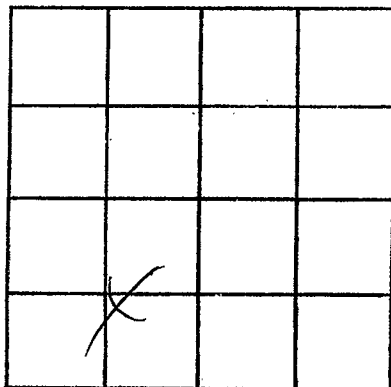

SECTION 12

Please indicate well location X.

ADDITIONAL INFORMATION

If more than one screen, show locations of each on sketch.