

PIKE  
H 2012  
5-4-79

MISSISSIPPI  
BOARD OF WATER COMMISSIONERS  
416 North State Street  
Jackson, Mississippi 39201

WATER WELL DRILLERS LOG

5-4

date well completed

1979

Fitzgerald Well Service  
firm name

Pike

county well located

LANDOWNER:

Herman Pice

R.R. Magnolia, Mo -  
(mailing address)

description of formations encountered

from

to

Red clay	0	20
Red sand	20	80
Coarse sand & gravel	80	117

WELL LOCATION:

sec. 36 T 20 N R 8 E  
S W  
4 miles NW of Progress  
(distance) (direction) (nearest town)

WELL PURPOSE:

(home, irrigation, municipal, industrial)  
Home

WELL COMPLETION DATA:

- (1) diameter (inches) 4
- (2) total depth (feet) 117
- (3) static water level (feet) 80 below above top of ground.
- (4) casing PVC, 109, (material) (depth)  
4 (size) if telescope see back.
- (5) screen 8, 109 (length) (depth to top)  
4 (size) PVC (material)
- (6) pump 1/2, 10 (HP) (yield gpm)  
Elec (type power)
- (7) electric log yes no
- (8) how well bottom plugged sand shell

DRILLERS REMARKS:


Miss. Board of Water Comm.

JUL 17 1979

RECEIVED

If well telescopes please sketch and show depths.

GROUND LEVEL

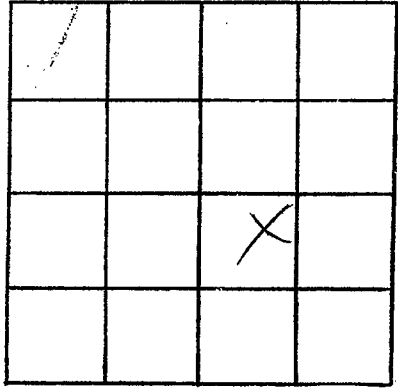

SECTION 36

Please indicate well location X.

ADDITIONAL INFORMATION

A series of horizontal lines for recording additional information.

If more than one screen, show locations of each on sketch.