

Pike
H 203
8-28-79

MISSISSIPPI
BOARD OF WATER COMMISSIONERS
416 North State Street
Jackson, Mississippi 39201

WATER WELL DRILLERS LOG

8-28 date well completed 19 79 firm name F. General Well Drill county well located Pike

LANDOWNER:
James T. Saldan
P.R. Magnolia
(mailing address)

description of formations encountered	from	to
Reef clay	0	20
Reef sand	20	140
Coarse sand & gravel	140	156

WELL LOCATION:
sec. 3 T 2 N R 8 E
S W
4 miles E of Magnolia
(distance) (direction) (nearest town)

WELL PURPOSE: drinking
(home, irrigation, municipal, industrial)

- WELL COMPLETION DATA:
- (1) diameter (inches) 4
 - (2) total depth (feet) 156
 - (3) static water level (feet) 97 below above top of ground.
 - (4) casing PVC, 148,
(material) (depth)
4 If telescope see back.
(size)
 - (5) screen 2, 148
(length) (depth to top)
4, PVC
(size) (material)
 - (6) pump 1/2, 60
(HP) (yield gpm)
60
(type power)
 - (7) electric log no
(yes or no)
(organization running log)
 - (8) how well bottom plugged Sand plug

DRILLERS REMARKS:


Miss. Board of Water Comm.

SEP 12 1979

RECEIVED

If well telescopes please sketch and show depths.

GROUND LEVEL

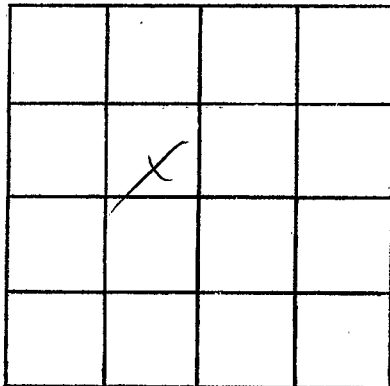

SECTION 3

Please indicate well location X.

ADDITIONAL INFORMATION

If more than one screen, show locations of each on sketch.