

Pike  
 H 2014  
 9-11-79

MISSISSIPPI  
 BOARD OF WATER COMMISSIONERS  
 416 North State Street  
 Jackson, Mississippi 39201

WATER WELL DRILLERS LOG

9-11 1979  
 date well completed

Fitzgerald Well Sew  
 firm name

Pike  
 county well located

LANDOWNER:  
 Francis Jackson  
 RR-5 McComb  
 (mailing address)

description of formations encountered	from	to
Red clay	0	20
Red sandstone	20	120
Coarse sandstone	120	130

WELL LOCATION:  
 sec 22 T 20 N R 5 E  
 S W  
 9 miles E of McComb  
 (distance) (direction) (nearest town)

WELL PURPOSE: Home  
 (home, irrigation, municipal, industrial)

- WELL COMPLETION DATA:
- (1) diameter (inches) 4
  - (2) total depth (feet) 130
  - (3) static water level (feet) 90 below top of ground.
  - (4) casing PVC, 122, (material) (depth)  
 4 (size) if telescope see back.
  - (5) screen 8, 122 (length) (depth to top)  
 4, PVC (size) (material)
  - (6) pump 1/2, 10 (HP) (yield gpm)  
 Elc (type power)
  - (7) electric log (yes or no) (organization running log)
  - (8) how well bottom plugged sand shell

DRILLERS REMARKS:


DEPT. OF NATURAL RESOURCES  
 BUREAU OF LAND & WATER RESOURCES

NOV - 7 1979

RECEIVED

If well telescopes please sketch and show depths.

GROUND LEVEL

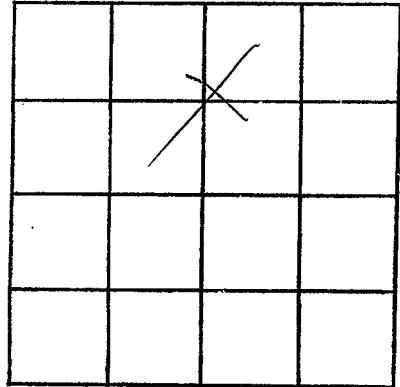

SECTION 22

Please indicate well location X.

ADDITIONAL INFORMATION

If more than one screen, show locations of each on sketch.