

Pike  
 4 2015  
 4-21-80  
 4-21

MISSISSIPPI  
 BOARD OF WATER COMMISSIONERS  
 416 North State Street  
 Jackson, Mississippi 39201

WATER WELL DRILLERS LOG

1980 Fitzgerald Well Log Pike  
 date well completed firm name county well located

LANDOWNER:	description of formations encountered	from	to
<u>Rickey Allen</u>			
<u>R.R. Magnolia</u> (mailing address)	<u>Red Clay</u>	<u>0</u>	<u>20</u>
	<u>Red Sand</u>	<u>20</u>	<u>110</u>
	<u>Coarse Sand &amp; gravel</u>	<u>110</u>	<u>120</u>

WELL LOCATION:  
 sec. 24 T. 2N S. R. 8E W.  
8 miles E of Magnolia  
 (distance) (direction) (nearest town)

WELL PURPOSE: Home  
 (home, irrigation, municipal, industrial)

- WELL COMPLETION DATA:
- (1) diameter (inches) 4
  - (2) total depth (feet) 120
  - (3) static water level (feet) 70 below top of ground.
  - (4) casing 4 1/2, 112,  
 (material) (depth)  
4 if telescope see back.  
 (size)
  - (5) screen 8, 112  
 (length) (depth to top)  
4, 4 1/2  
 (size) (material)
  - (6) pump 1/2 10  
 (HP) (yield gpm)  
Electric  
 (type power)
  - (7) electric log No  
 (yes or no)  
 (organization running log)
  - (8) how well bottom plugged Sand Sh. R.

DRILLERS REMARKS:


DEPT. OF NATURAL RESOURCES  
 BUREAU OF LAND & WATER RESOURCES

JUN 20 1980

RECEIVED

depths.

**GROUND LEVEL**

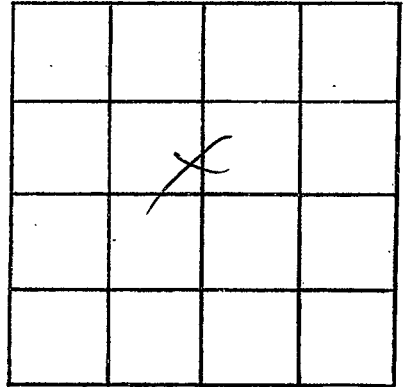

**SECTION 24**

**Please indicate well location X.**

**ADDITIONAL INFORMATION**

---

---

**If more than one screen, show locations of each on sketch.**