

DIKE  
H 2014  
6-9-80

MISSISSIPPI  
 BOARD OF WATER COMMISSIONERS  
 416 North State Street  
 Jackson, Mississippi 39201

WATER WELL DRILLERS LOG

date well completed 6-9 1980 firm name General Well Inc county well located DiKe

LANDOWNER:	description of formations encountered	from	to
<u>E.R. Mallette</u>	<u>Red clay</u>	<u>0</u>	<u>20</u>
<u>R.R. Mannel</u> (mailing address)	<u>Red sand &amp; gravel</u>	<u>20</u>	<u>110</u>
WELL LOCATION:	<u>Coarse sand &amp; gravel</u>	<u>110</u>	<u>120</u>
sec. <u>16</u> T. <u>2</u> N R. <u>8</u> E S W			
<u>6</u> miles <u>E</u> of <u>Myrtle</u> (distance) (direction) (nearest town)			
WELL PURPOSE: <u>Home</u> (home, irrigation, municipal, industrial)			
WELL COMPLETION DATA:			
(1) diameter (inches) <u>4</u>			
(2) total depth (feet) <u>120</u>			
(3) static water level (feet) <u>95</u> below top of ground.			
(4) casing <u>PVC</u> , <u>112</u> , (material) (depth)			
<u>4</u> (size) if telescope see back.			
(5) screen <u>8</u> , <u>112</u> (length) (depth to top)			
<u>4</u> , <u>PVC</u> (size) (material)			
(6) pump <u>1/2</u> <u>10</u> (HP) (yield gpm)			
<u>Ele</u> (type power)			
(7) electric log <u>no</u> (yes or no)			
(organization running log)			
(8) how well bottom plugged <u>Seal slub</u>			
DRILLERS REMARKS:			


DEPT. OF NATURAL RESOURCES  
 BUREAU OF LAND & WATER RESOURCES

JUN 20 1980

RECEIVED

If well telescopes please sketch and show depths.

GROUND LEVEL

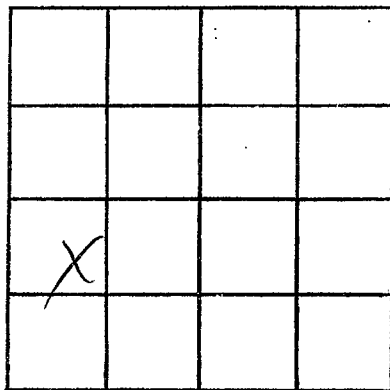

SECTION 16

Please indicate well location X.

ADDITIONAL INFORMATION

If more than one screen, show locations of each on sketch.