

Pike
H 2017
7-8-80

MISSISSIPPI
BOARD OF WATER COMMISSIONERS
416 North State Street
Jackson, Mississippi 39201

WATER WELL DRILLERS LOG

Pike

7-8
date well completed

1980 Filsuall well serv
firm name

Walthall
county well located

LANDOWNER:	description of formations encountered	from	to
Yemou Rayburn P.R. - M. Lomb, M. (mailing address)			
WELL LOCATION:			
sec. 36-T-20N R-8E 5 miles 4 of Jones (distance) (direction) (nearest town)			
WELL PURPOSE: Home (home, irrigation, municipal, industrial)			
WELL COMPLETION DATA:			
(1) diameter (inches) 4			
(2) total depth (feet) 150			
(3) static water level (feet) 90 below top of ground.			
(4) casing PVC, 142, (material) (depth)			
4 (size) If telescope see back.			
(5) screen 8, 142 (length) (depth to top)			
4 (size) PVC (material)			
(6) pump 1, 20 (HP) (yield gpm)			
Elc (type power)			
(7) electric log no (yes or no)			
(organization running log)			
(8) how well bottom plugged			
DRILLERS REMARKS:			


DEPT. OF NATURAL RESOURCES
BUREAU OF LAND & WATER RESOURCES

SEP 8 - 1980

RECEIVED

If well telescopes please
sketch and show depths.

GROUND LEVEL

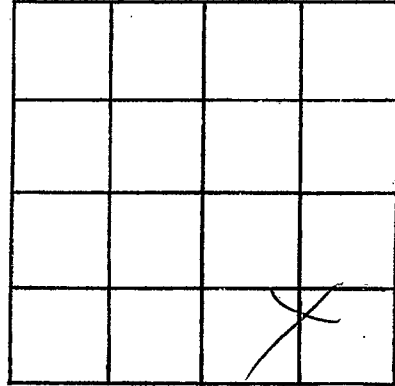

SECTION 36

Please indicate well location X.

ADDITIONAL INFORMATION

If more than one screen,
show locations of each on sketch.